


R. 12 W.

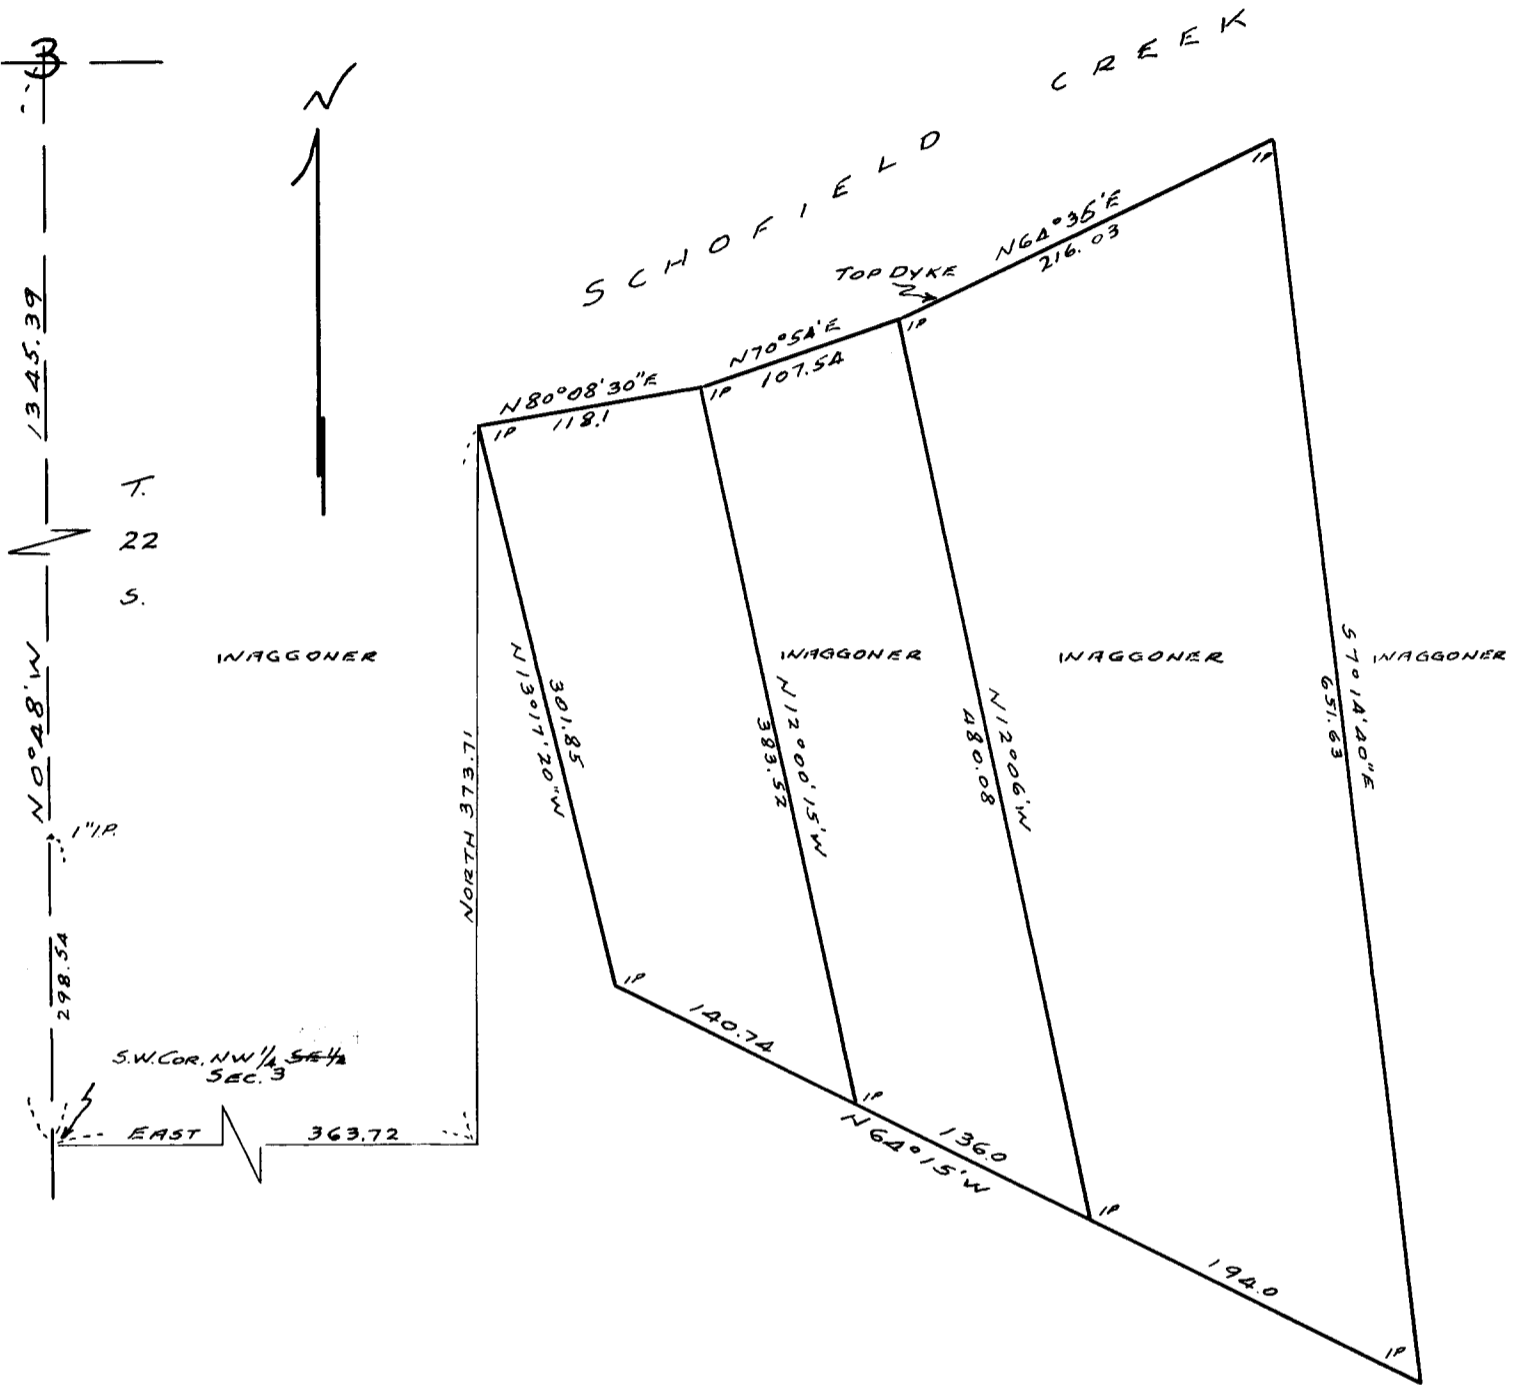

COUNTY SURVEYORS FILE DATA  
DO NOT REMOVE FROM OFFICE

WAGGONER SURVEY  
SEC. 3, T. 22 S., R. 12 W., W. M.  
DOUGLAS COUNTY  
Scale 1" = 100' Oct. 1960.

FRED L. L.

COUNTY SURVEYOR