

REN.

T 31 S R 3 W

COR.

3/2

SECS.

10/11

AT COR. FD. WOODEN STAKE SET

BY MARKHAM.

FD. INCENSE CEDAR (NOW 14" DIAM.)

S 25 1/4° E 24° FT. - GOOD SCRIBING

"3 W S 11" VISIBLE ON PREVIOUSLY  
OPENED SCAR.

FD. INCENSE CEDAR (NOW 30" DIAM.)

S 63 3/4° W 28° FT. - SHOWS GOOD

AXE SCARS.

FD. 33" FIR N 59° W 12° FT. UPROOTED

& DOWN.

NO TRACE FD. OF ORIG. N.E. TREE.

ALL TREES MKD. BY MARKHAM

IN 1959 ARE ALIVE & IN GOOD CONDITION.

4" FIR S 62° E 3 1/2 FT.

3" FIR S 84° W 15 1/2 FT.

6" FIR N 10° W (NOT S 10° W) 33 1/2 FT.

12" CHIND. N 16° E 62° FT.

AT COR. SET IRON PIPE WITH

BRASS CAP MKD. "COUNTY SURVEYOR'S

OFFICE 1964 T 31 S R 3 W S 3 | S 2 "

S 10 | S 11

DRIVE MARKHAM'S STAKE ALONGSIDE.

NO NEW TREES SCRIBED.

SEE REN. # 47

JUNE 30, 1964

Milo C. Godfrey

M. G.

W. S.

M. D.


M. S.

8 ↓

C. S. File No. 52/63-8

REPORT ON CORNERS OF THE CADASTRAL SURVEY GRID

T. 31S R. 3W Will Mer., Oregon State.

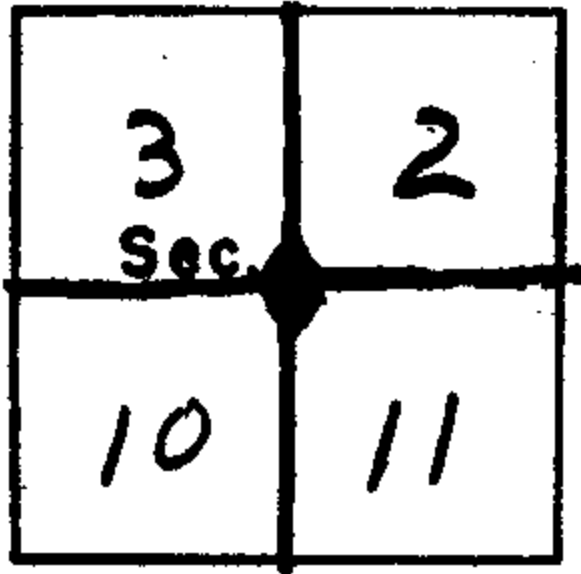

SYMBOLS

- ◆ Official corner found.
- ◇ Corner found, authenticity doubtful.
- Corner searched for and not found.

RENEWED  
JUNE 30, 1964  
Paul E. Goffey

DESCRIPTION OF CORNER MONUMENT

4' stake 2" x 2"

|  |  |   |
|--|--|---|
| BT.<br>D.F.-33'<br>N39°30'W<br>26.4' orig. | BT. D.F.<br>Dead & down<br>N 89 E<br>10.0' orig. | BT.<br>Cedar 28.8"<br>N 62 E<br>28.0' orig. |
|--|--|---|

DESCRIPTION OF BEARING TREES, MOUND OF STONE, ETC

|   |  |   |  |
|---|--|---|--|
| BT.<br>D.F.-5.4"<br>N 64 W<br>3.6'<br>New | BT.<br>Chinkapin 16.9"<br>S 16°45' W<br>61.0'<br>New | BT.<br>D.F.-5.1"<br>S 80 W<br>15.2'<br>New. | BT.<br>D.F.-9.2"<br>S 8°30' W<br>33.0'<br>New. |
|---|--|---|--|

DESCRIPTION OF LOCATION TO ENABLE RECOVERY BY OTHERS.

Corner is at juncture of 2 cutting lines. Cat Road to corner is about 5 chains East. This cat road joins the Stout creek road.

3/5/64  
(Date)

Reported by Paul R. Goffey  
(Signature)  
Forester  
(Title)