

REN.

T 31 S R 3 W

COR. 4/3
SECS. 9/10

AT COR. FD. STONE AS CALLED FOR
IN GOV'T NOTES,

FD. FIR SNAG (NOW 18" DIAM.)

S 24° E 14 1/2 FT. - PREVIOUSLY OPENED -
GOOD SCRIBING VISIBLE "R 3 W"

FD. FIR TREE (NOW 38" DIAM.)

S 65 1/2° W 12 1/2 FT. - SHOWS GOOD LOWER
SCAR. - TREE IN GOOD CONDITION

FD. FIR TREE (NOW 12" DIAM.)

N 49° W 25 1/2 FT - SLOPE DIST. -
VERY PLAIN SCARS VISIBLE. GOOD CONDITION.

THE 48" FIR N 27 1/2° E 41 1/2 FT.
IS UPROOTED & DOWN - SCARS VISIBLE.

AT COR. SET IRON PIPE WITH
BRASS CAP MKD. "COUNTY SURVEYOR'S
OFFICE 1964 T 31 S R 3 W 54/53"

59/510

BLAZE & SCRIBE 2 NEW TREES:

15" INCENSE CEDAR S 14° E 37 1/2 FT.

MKD. "T 31 S R 3 W 510 CS BT"

36" DOUG. FIR N 22° E 56 1/2 FT.

MKD. "T 31 S R 3 W 53 CS BT"

JULY 20, 1964


Milo E. Coffey

M. E.
W. S.
M. S.

+ 10

REPORT ON CORNER OF THE CADASTRAL SURVEY GRID

315 R, 3W W. 7 Mer., Oregon State.

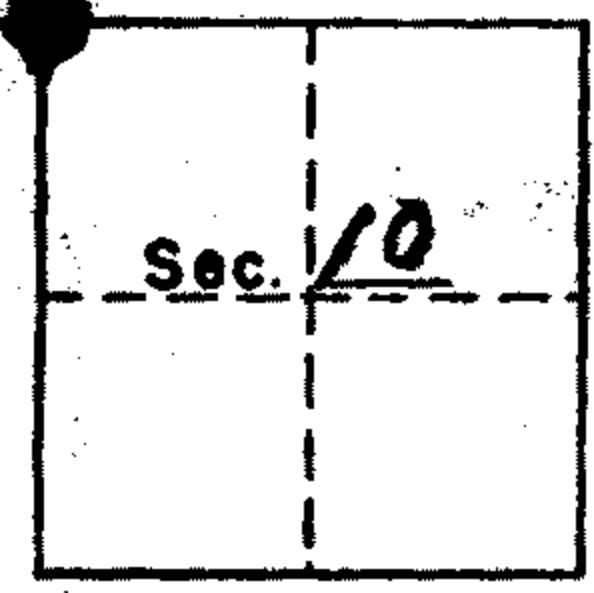

SYMBOLS

- ◆ Official corner found.
- ◇ Corner found, authenticity doubtful.
- Corner searched for and not found.

RENEWED
JULY 20, 1964
Wils. C. Coffey

DESCRIPTION OF CORNER MONUMENT

Unable to locate corner. Request county set brass cap from original B.M.

DESCRIPTION OF BEARING TREES, MOUND OF STONE, ETC.

- 4 Bearing trees with original scribbles were found
- 18" D.F. snag - found original scribble
- 20 D.F.
- 40" D.F.
- 48" D.F.

DESCRIPTION OF LOCATION TO ENABLE RECOVERY BY OTHERS.

proceed up Stout Creek
to wash out in road. Cross creek
at this point and proceed up side
draw ~~to~~ bearing of J. P. [unclear] (over)

3-13-64
(Date)

Reported by J. P. [unclear]
(Signature)
[unclear]
(Title)

right part two creek junctions

approximately 600' past 2nd

Creek junction fruit bearing

Trees with blue flagging