

REN. T 31 S R 3 W

1/4 S 9 1/10

BOTH B.T.'S FD. - WILL NOT CHECK FOR BEARINGS & DISTANCES AS GIVEN IN FIELD NOTES. - I FOUND THAT BY REVERSING DISTANCES TO THE TWO TREES, BOTH BEARINGS CHECK. ALSO FACINGS ARE BETTER THIS WAY THAN USING ANY OTHER SOLUTION.

FD. INCENSE CEDAR (NOW 30" DIAM.)

N 33 1/2° E 24 1/2 FT (NOT 19 1/2 FT.)

PREVIOUSLY OPENED. - GOOD SCRIBING VISIBLE "1/4 S" - TREE IN GOOD CONDITION.

FD. CEDAR SNAG (NOW 27" DIAM.)

N 43 1/2° W 19 1/2 FT. (NOT 24 1/2 FT.) -

PREVIOUSLY OPENED. - GOOD SCRIBING VISIBLE "1/4 S"

AT COR. SET IRON PIPE WITH BRASS CAP MKD. "COUNTY SURVEYOR'S OFFICE 1964 T 31 S R 3 W

1/4 S 9 1/10"

BLAZE & SCRIBE ONE NEW TREE!

12" MADRONE N 86 1/2° W 21° FT.

MKD. "1/4 S 10 CS BT"

JULY 20, 1964

Milo E. Godfrey


M.G.
W.S.
M.S.

+ X O

C. S. File No. 52/63-13

REPORT ON CORNERS OF THE CADASTRAL SURVEY GRID

T. 35 R. 3W Will Mer., Oregon State.

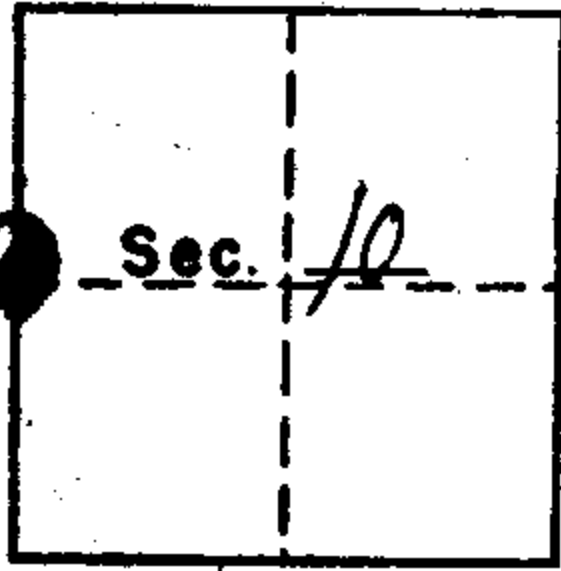

SYMBOLS

- ◆ Official corner found.
- ◇ Corner found, authenticity doubtful.
- Corner searched for and not found.

RENEWED
JULY 20, 1964
Milo E. Goffey

DESCRIPTION OF CORNER MONUMENT

unable to locate corner. Request County # set brass cap from original P.T.s

DESCRIPTION OF BEARING TREES, MOUND OF STONE, ETC.

18" T. Cedar - found original scriber
16" T. Cedar

DESCRIPTION OF LOCATION TO ENABLE RECOVERY BY OTHERS

proceed up Stout Creek to wash out in road. Cross Creek at this point and proceed up side draw bearing (over)

3/3-64
(Date)

Reported by J. P. Pugh
(Signature)

(Title)

right past two creek junctions
approximately 600' past the
second creek junction find
blue flagging indicating original
bearing trees for the NW section
corner of section 10. Proceed
^{40 chains}
south along old blaze to
 $\frac{1}{4}$ corner between 9, 5/10. Find
original BT'S with blue
flagging