

Renew Sec. Cor. $\frac{512}{513}$ T265 R2W & R1W

Ed. Mound of Stone BN BTs as follows -
Orig. 48" FIR S. 85° W. 27' ft. (face)

Burned Sign - NO SCRIBE FOUND.

Orig. 24" Now 30" FIR N. 55° W. 36' ft. (Face slope)

ReBARK scribed "T265 512 R2WCS BT" & Orig

BARK scribe "12" 2 live.

8" Now 11" FIR S. 40° W. 132 ft (slope)

Not S. 36° W. 25 Recorded.

Good SCARS we do not open - Recorded in

Ren. # 3 of T265 R2W. We set 1" I.P. & BRASS

CAP IN MOUND OF Stone MKd. COUNTY

SURVEYORS OFFICE 1966 T265

R2W $\frac{512}{513}$ R1W " BT's at cor in

good cond. - we do not mark new ones.

March 5, 1966

V.R.T.
M.S.
J.H.

[Signature]
**FILED
RECEIVED**


APR 4 1966

**COUNTY SURVEYOR
DOUGLAS COUNTY, ORE.**

[Handwritten marks]
X-1-1W

C.S. File No. 52-117-1D J.B.

Section 12 + 13 Twp 26S Rge 2W Date: 3/26/66

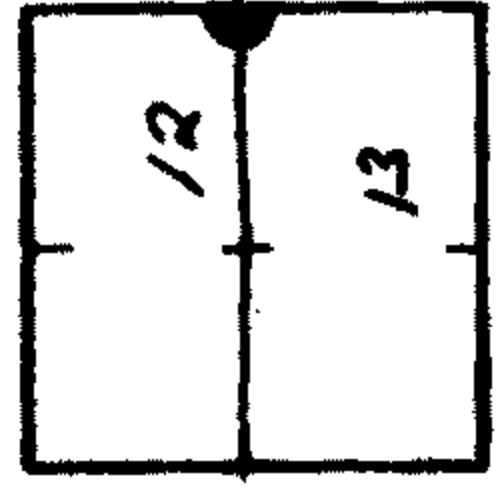

How was corner identified? Pile of rock

Condition of corner: poor

Renewed 3/5/66

V.R.M.
M.S.
J.H.

Best route to reach corner: Bris Ranch Road

(Signature)

Quadrant	NE	NW	SE	SW
Species & Size			14" Fir	8" Fir
Dist. & Bearing			6' S45°E	12' S38W
Condition of Scribe			-	-
Original or Resurvey			-	-
Appearance of B.T.			-	-
Tags, Marks, etc.				

Other Remarks:

Distances do not agree with survey notes.
Rocks may have slid down hill. Needs iron pipe & cap set.
(Signature)

Signed