


RENEW 1/4 T 285  
56

FOUND - BRASS CAP AT COR,  
AND 16" NEW 22" FIR  
STUMP N 47° W 3 B 1' WE OPEN  
FIND GOOD SCRIBING SW  
BT NOT FOUND

NEW BT'S.

12" R FIR BEARS N 75° W 287  
SCRIBED 1/4 56 CS BT

14" R FIR BEARS N 29 1/2° W 397  
SCRIBED 1/4 56 CS BT

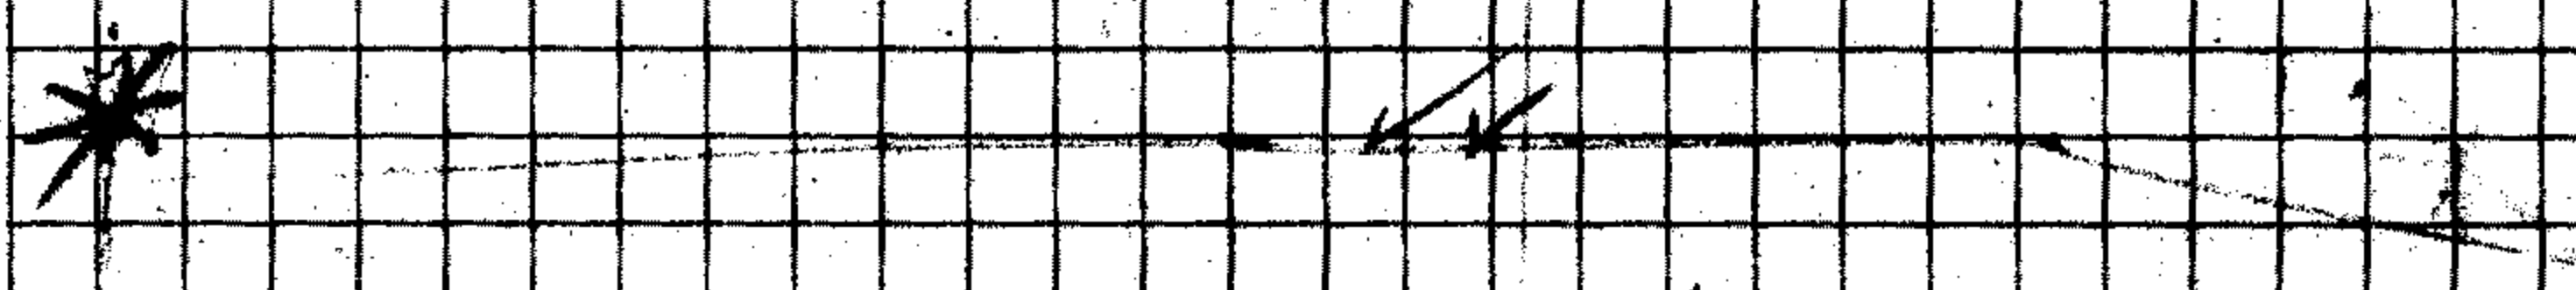

RENEW 1/4 COR 51 | 56  
FY BRASS CAP RW RT 1/2  
NW BT NEW STUMP SE BT IS OK

NEW BT  
17" R FIR BEARS N 70° W 370  
RECENTLY SCRIBED 1/4 51  
AND OTHER SCRIBING 1/4

RENEW 56  
T 285 57  
R 7 1/2 W

FOUND - BRASS CAP AT CORNER #  
SW BT OK  
MARK NEW BT  
12" CEDAR BEARS N 22° E 43  
SCRIBED 1/4 56 CS BT

*Handwritten signature:* J. J. [unclear]

MAY 5-61  
J. J.

C. S. File No. 57-19-12

DIETZGEN NO. 385-6