

Renew N.W. COR. DLC #49 T285 R7W  
Fd.  $\frac{1}{2}$ " I.P. 18" Long & O.B.T.s Recorded  
in Ren. #15 by G.G. Stewart in 1922  
as follows -

16" Now 18" B. Oak N.  $86^{\circ}$  E.  $9^{\frac{5}{8}}$  ft,  
Now 14 ft. high snag. - scribe MKs  
Visible on opened blaze.

18" B. Oak N.  $8\frac{1}{2}^{\circ}$  W.  $18^{\frac{5}{8}}$  ft,  
Only stub of stump & Burned Log  
Remains - no scribe Fd. at cor.  
Point set 1" I.P. & Brass cap MKd,

"COUNTY SURVEYOR'S OFFICE  
1968 T285 R7W N.W. DLC. [49]"  
& Reset I.P. along side. MK. New B.T.s -

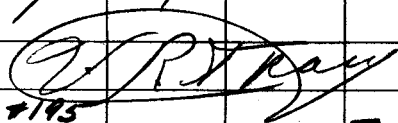
6" D. Fir N.  $29^{\circ}$  E.  $32^{\frac{5}{8}}$  ft,  
MKd. "NW DLC 49 CS BT"

6" D. Fir S  $13^{\circ}$  W.  $41^{\frac{1}{4}}$  ft,  
MKd. "NW DLC 49 CS BT"

This cor. lies on steep south  
slope densely covered with  
Laurel & a few Fir.

Sept 4, 1968

U.R.T.  
V.P.

  
#195

G.S. File No. 52/79-33  
S.K. J.W. 13