

REN.

T26 S R6 W

 MEANDER COR.
 RIGHT BANK
 (S. UMPQUA) $\frac{9}{32} \frac{9}{33}$

FD. OLD PINE STUMP (NOW 30" DIAM.)

N60°W 49⁵ FT. - OPENED & FD.

GOOD SCRIBING "R6" & "S"

NO TRACE OF S.E. TREE FD.

LOCATION FOR MEANDER COR.

FALLS ON BED ROCK IN RIVER CHANNEL

AND WOULD BE UNDER WATER EXCEPT

IN TIME OF LOW WATER.

SET WIT. COR. ON HIGH BANK

60 FT. NORTH OF MEANDER COR. -

SET IRON PIPE WITH BRASS CAP MKD.

"COUNTY SURVEYOR'S OFFICE 1964

T26 S R6 W W.C. M.C. $\frac{5}{32} \frac{9}{33}$

60 FT. S. TO COR."

BLAZE & SCRIBE NEW TREES:

16" BLACK OAK S 80° W 50³ FT.

MKD. "W C M C S32 CS BT"

15" WHITE OAK S 75° E 3⁵ FT.


MKD. "W C M C S33 CS BT"

WIT. COR. IS ALONG SIDE ELECTRIC

SERVICE (ON TREE) FOR MOTOR &

IRRIGATION PUMP

JULY 29, 1964

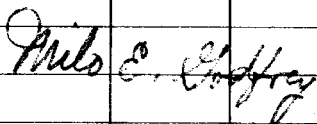

 M.G.
 M.S.

C. S. File No.

52/87-79