

REFERENCE

1/4

59

T 295 R 2W


S 16

V.R. 20 1/2

SEPT 1, 1961

U.S. B.  
U.S. M.  
U.S. P.

DIETZGEN NO. 385-6

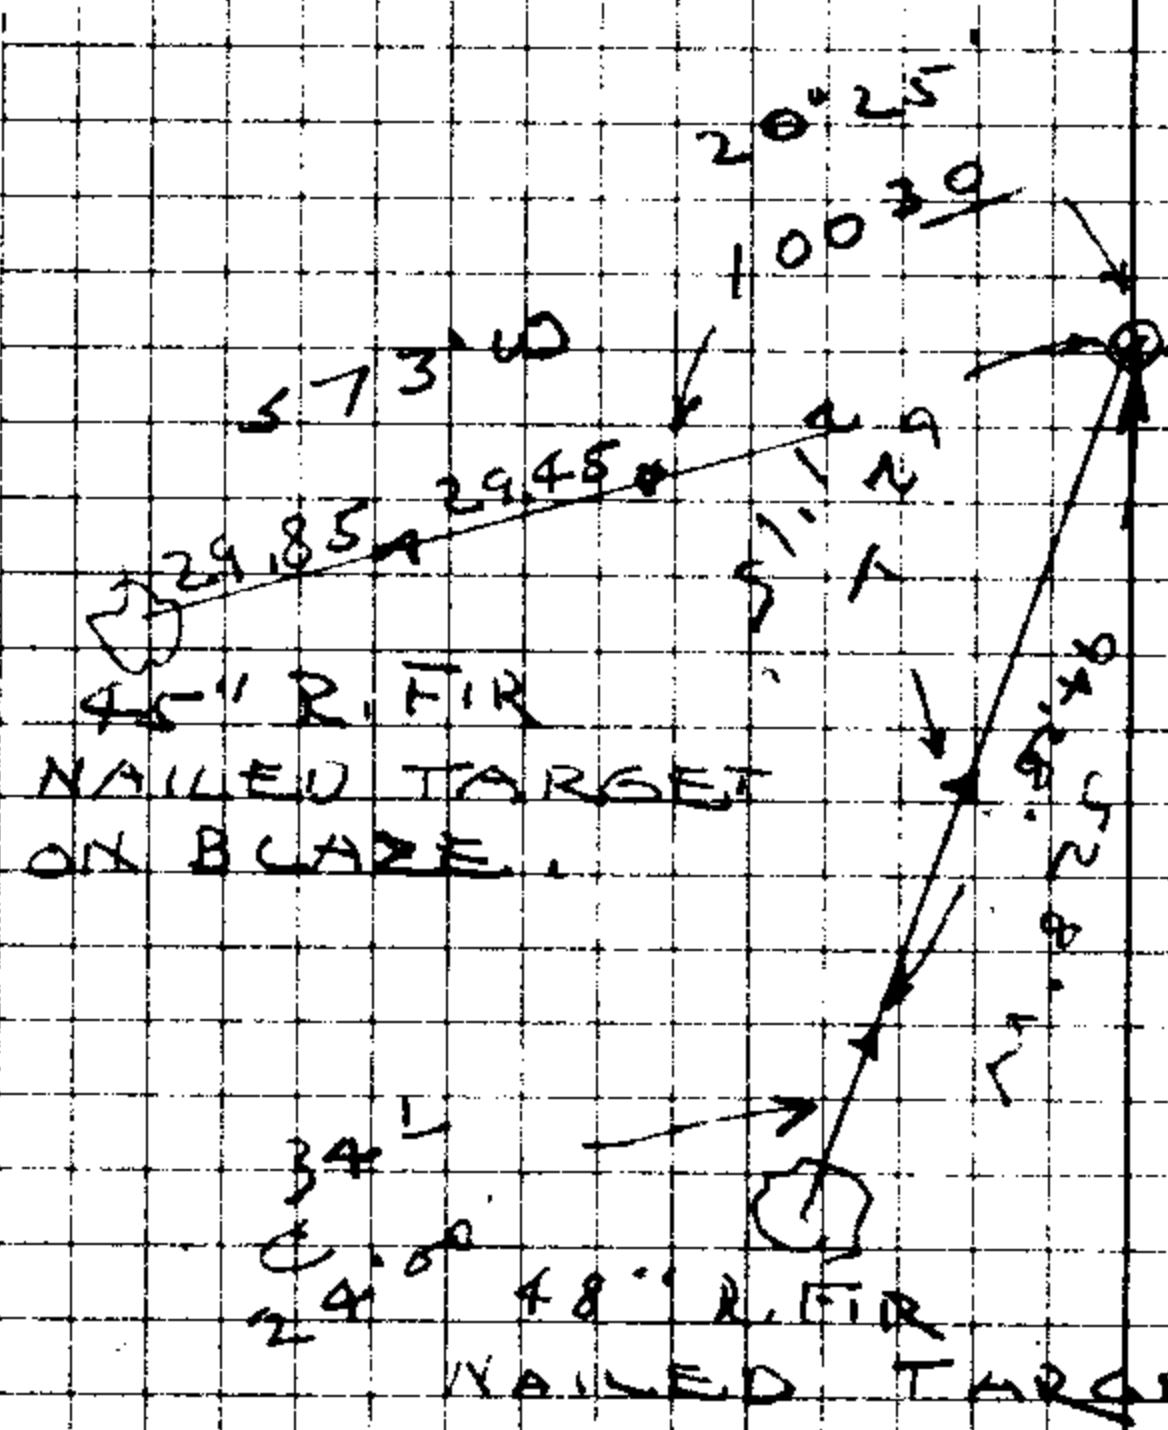

1/4 COR. T 295 R 2W

I FIND BOTH BITS AND BRASS CAP WHICH I REMOVE AND TIE TO 45' TREE.

45' R. FIR NAILED TARGET ON BLADE.

48' R. FIR NAILED TARGET ON BLADE

\* ✓ +

C. S. File No. 52/89