


COUNTY SURVEYORS FILE DATA
DU 1961, REAMOVE FRONT DEPICT

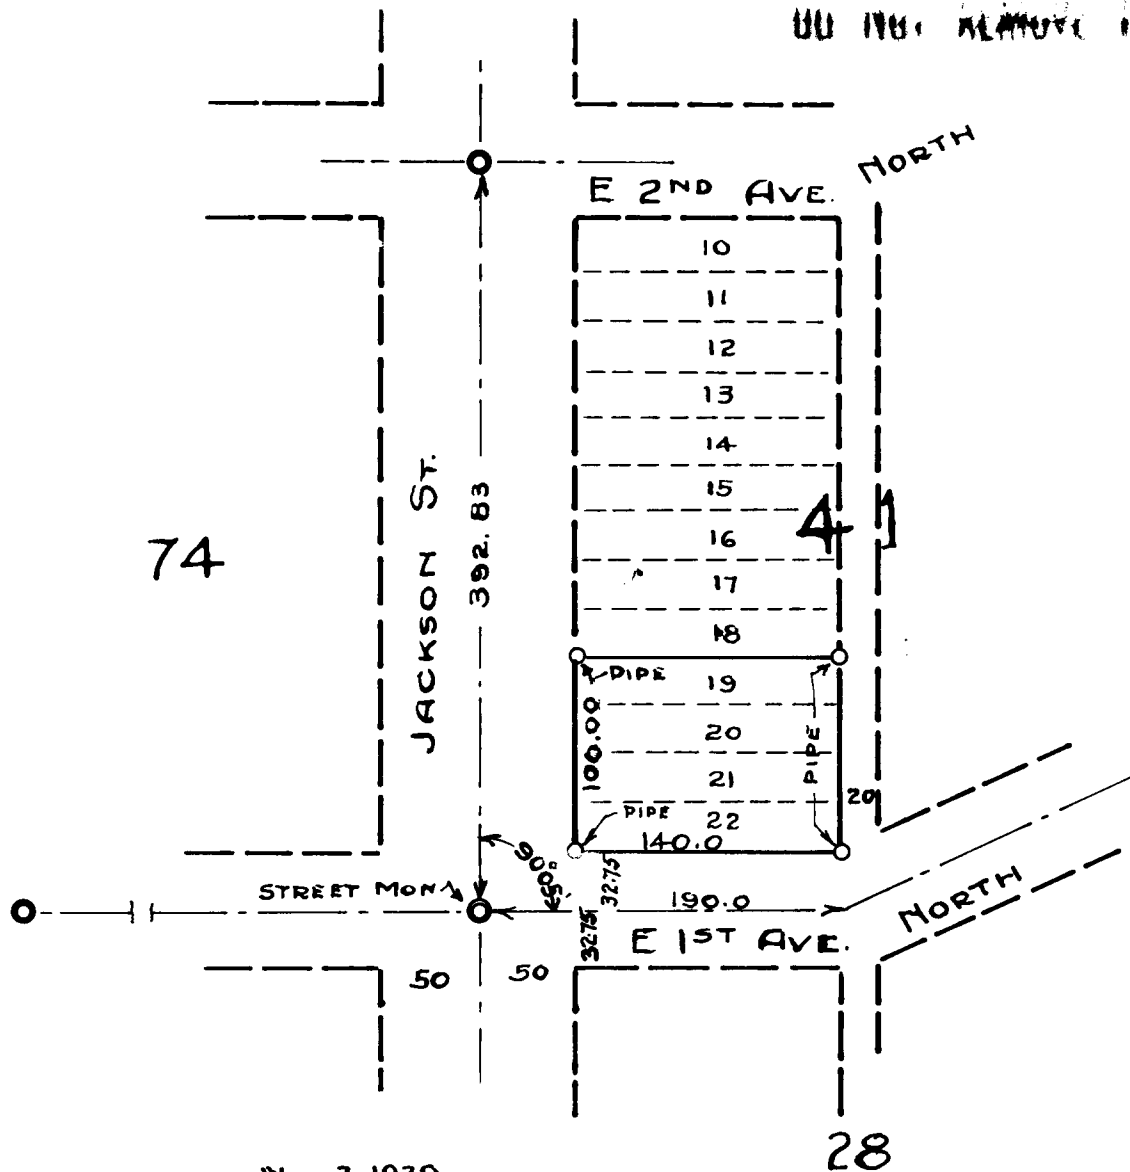

SURVEYED Nov. 3, 1939
SCALE 1" = 100'

LOTS 19-20-21-22 BLOCK 41
KINNEY'S IMPROVED PLAT
ROSEBURG, OREGON
BEN. B. IRVING,
CIVIL ENGINEER & SURVEYOR,
ROSEBURG OREGON.

CS FILE FOLDER

CONTAINS

MORE

INFORMATION