

T 19 S R 9 W S26
S35

SET WITNESS COR. FOR $\frac{1}{4}$ COR S26
S35

T 19 S R 9 W.


$\frac{1}{4}$ COR. IS BRASS CAP (G.L.O. SURVEY
1958). COR. & B.T.'S WILL BE DESTROYED
BY ROAD CONSTRUCTION.

SET WIT. COR. S70°W 130° FT.
FROM TRUE $\frac{1}{4}$ COR.

SET IRON PIPE WITH BRASS CAP
MKD "COUNTY SURVEYOR'S OFFICE 1961

T 19 S R 9 W W.C. $\frac{1}{4}$ S26
S35 N70°E

130° FT. TO COR. SET $\frac{3}{4}$ " IRON ROD
S70°W 48²⁵ FT. FROM WIT. COR., THUS

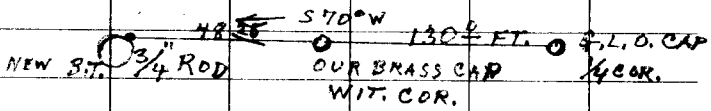

BLAZE & SCRIBE NEW BEARING TREES!

43" DOUGLAS FIR S 62°W 48³ FT. MKD.

" W.C. $\frac{1}{4}$ S 35 CS BT "

36" DOUGLAS FIR N 70°W 61^L FT. MKD.

" W.C. $\frac{1}{4}$ S 26 CS BT "

NOV. 9, 1961

M.G.

V.T.

C.P.

WORK DONE
FOR U.S. ROAD.
MAPLETON
T 19 S R 9 W

Mils & [unclear]

C.S. File No. 52/99