

Renewal #23


NW D.C. cor #41 TAGS RBW

Found

16" W Oak NW 20" West 99  
opened for scribe "BT"

Renewal

Set Brass cap at D.C. cor MKR  
County Surveyors office  
TAGS RBW

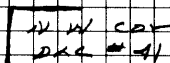

1969


DIETZGEN NO. 385-6

New Bearing Tree

10" W Oak N 29 E 65  
Scribed NW D.C. #41 CS BT

Note:

This cor lies S 45 E 2"  
from Fence cor. Fence Running  
E-W & South.

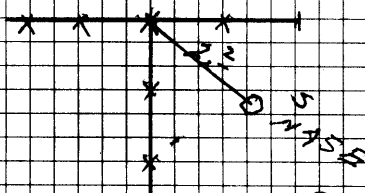

D.K.  
S.W.B.

9-12-69

#89

U.S. File No. 52102-3