

Renew  $\frac{1}{4}$   $\frac{532}{55}$  T235 R. 6W

Fd. 460. BRASS Cap MKd. "T235 R6W"

$\frac{1}{4}$   $\frac{532}{55}$  T245 R6W 1957 " & one Live

B.T. -

16" now 18" W, FIR S, 61° W. 52  $\frac{8}{5}$  FT.

Nearly healed Blazes - Partial scribe

Mks visible, orig. NE. B.T. is stump.

orig. SE. B.T. Turned out, & 1957 N.W.

B.T. Turned out, we MK. New B.T.s -

9" Hemlock, S, 40  $\frac{1}{2}$ ° E, 30  $\frac{8}{5}$  FT.

Mkd. " $\frac{1}{4}$  55 CS BT"

10" D. FIR. N. 38° W. 86  $\frac{5}{5}$  FT.


Mkd. " $\frac{1}{4}$  532 CS BT"

COR. Lies in old Logged off

unit.

Sept. 1, 1966

U.R.T.  
J.B.  
J.N.

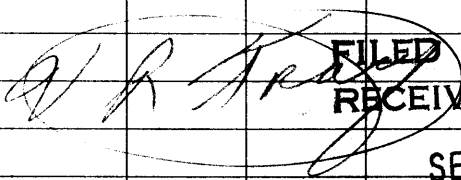

**FILED**  
**RECEIVED**

SEP 1 1966

COUNTY SURVEYOR  
DOUGLAS COUNTY, ORE.

Q 55-723-6

\* 87-524-6

C.S. File No. 52/102-28