

REN.

T 23 SR 6 W

1/4 S 1/4 S
19 30

FD. G. L. D. BRASS CAP AT COR.

THE 26" FIR S 46 1/2° E 19 8 FT.

IS UPROOTED & DOWN - UNDERNEATH
SEVERAL OTHER DOWN TREES:

THE 8" HEMLOCK N 36° W 10 6 FT.

(SCRIBING VISIBLE) IS LEANING BADLY
& WILL PROBABLY BE DESTROYED WHEN
DOWN TIMBER IS CLEARED OUT OF AREA;

BLAZE & SCRIBE 2 NEW TREES:

10" HEMLOCK N 9° W 57 8 FT.

MKD. "1/4 S 19 CSBT"

18" DOUGLAS FIR N 42° E 41 2 FT.

MKD. "1/4 S 20 CSBT"

MAY 17, 1963

Milo C. Godfrey

M.G.
V.T.
M.S.


PX!

G. S. File No.

5202-29

Section 19 Twp 23S. Rge 6W W

Date: 3-22-63

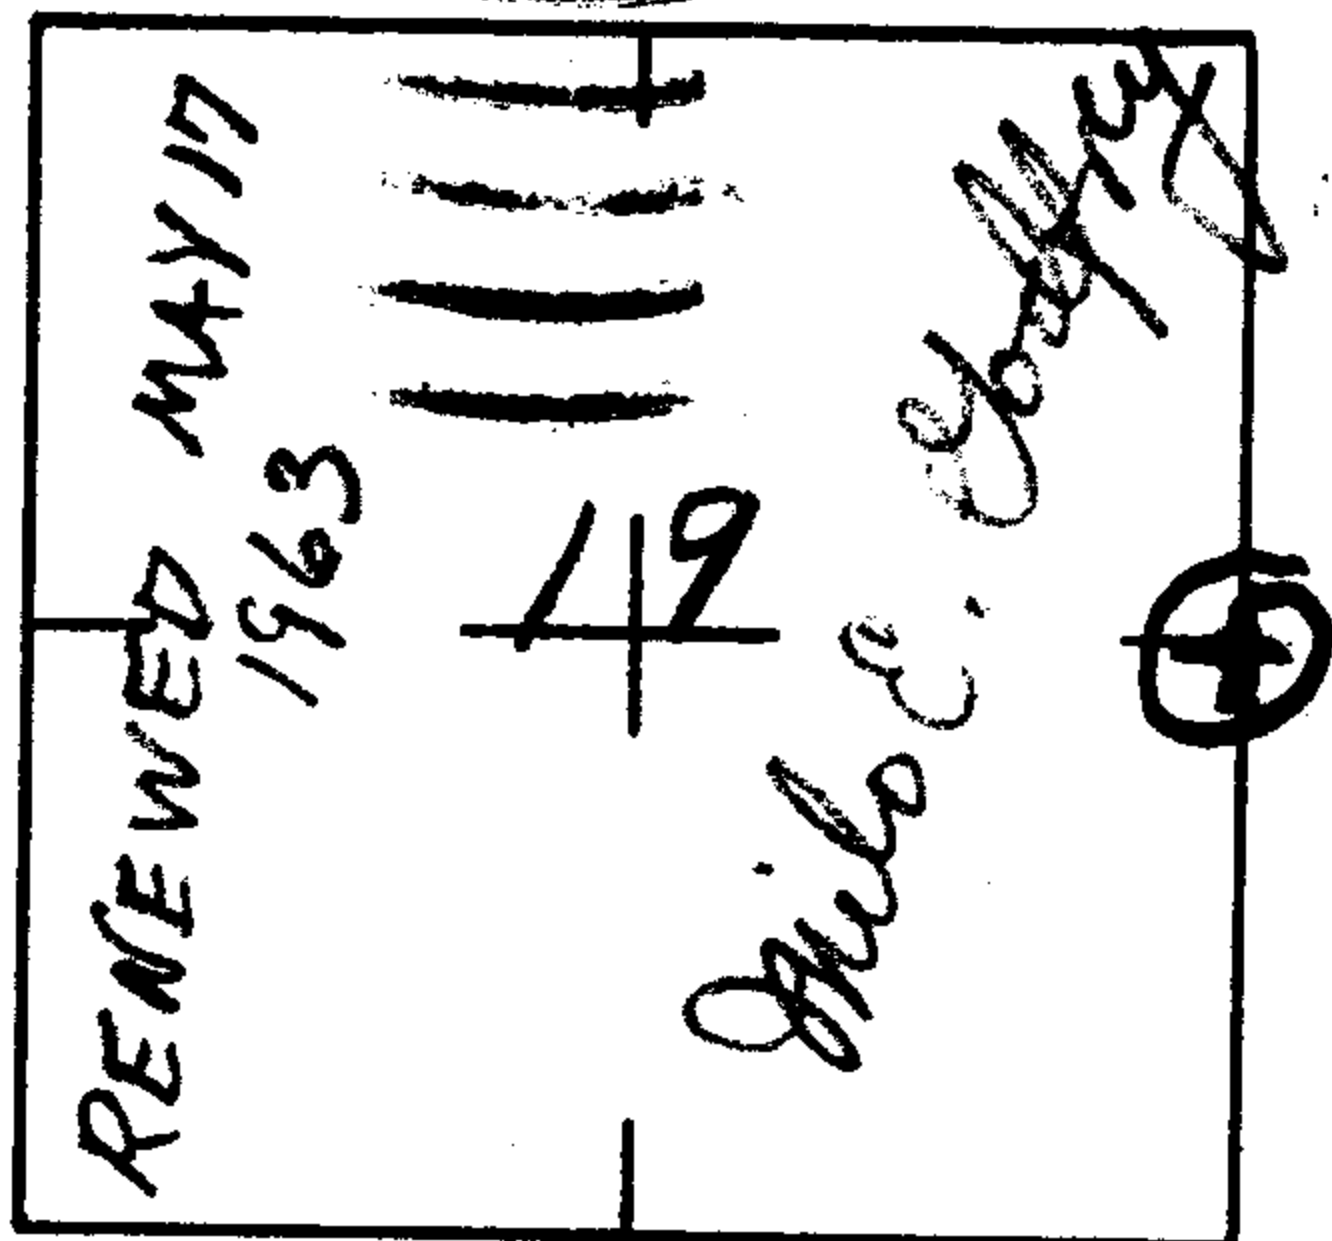

How was corner identified? Brass Cap

2 down B.T.'s (E 1/4)

Condition of corner: Both B.T.'s

(Cadastral corner)

Best route to reach corner: Brush Cr. Rd.

Cr. Rd., use high Rd. through Sect 19

Other Remarks:

to W line of Sec. 19, then walk up trail to Ridge top and E line of Sec. 19 (Dry Weather)
Robert Mitchell

Signed

Quadrant	NE	NW	SE	SW
Species & Size	D. F. 16"			DF. 32"
Dist. & Bearing				
Condition of Scribe	O.K.			
Original or Resurvey	Res.			
Appearance of B.T.	Leaning 30°			Down
Tags, Marks, etc.				