


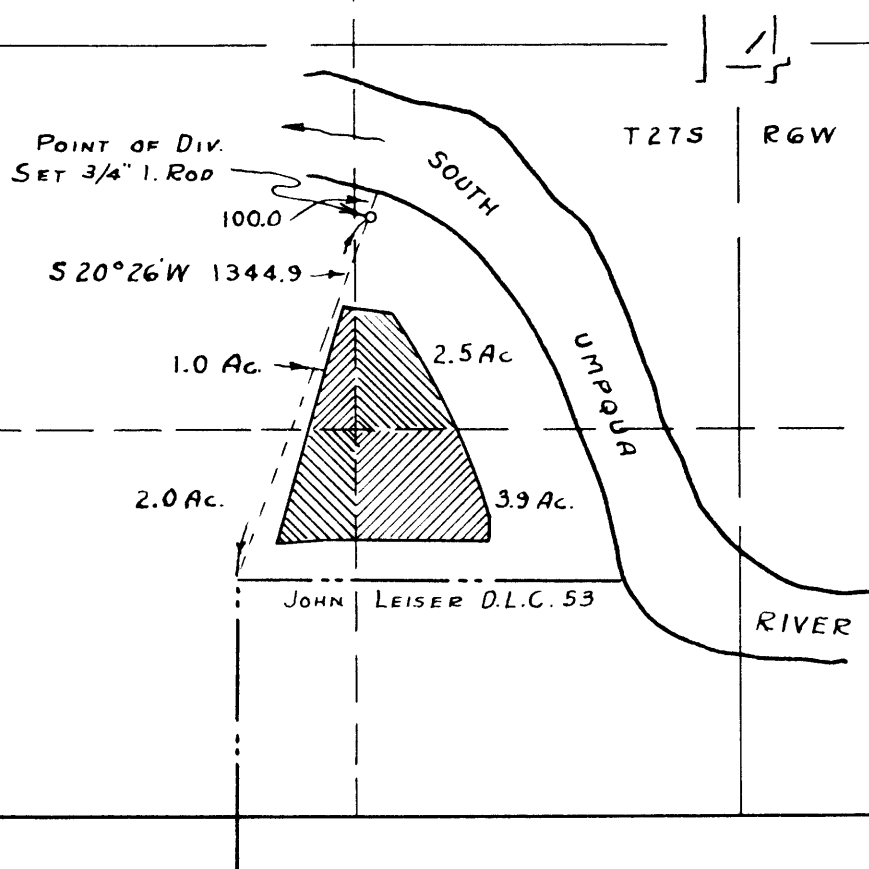

SCALE 8" = 1 MILE



WATER RIGHT
FOR
SCHOOL DISTRICT NO. 4
ROSEBURG, ORE.

OFFICE OF
FRED M. DARBY
COUNTY SURVEYOR, DOUGLAS CO.,
ROSEBURG, OREGON.