


RENEW ~~11/10~~ 9/10 T29S R1W

FOUND - BRASS CAP AT CORNER
ORIG. 4" N 20° W 40' FIR SNAG
5.25' W 5" N 40.9' SHOWS OLD
WELL WORK NO SCRIBING FOUND
ORIG. WE #1 NOT FOUND.

NOTE - THIS CORNER IN OLD BURN
AREA LIES AT TOP BANK AND
ON EAST SIDE OF DUMONT CRK

NEW
14" R. FIR BRASS N 62° E 32'
SCRIBED 1/4 S 9° S 10' BT

DIETZGEN NO. 385-6

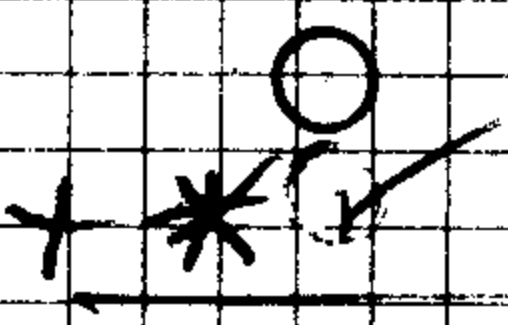

RENEW ~~9/10~~ 11/15 T29S R1W

FOUND - ALL ORIG. BTS.
EXCEPT SW BT. WE ALSO
FIND STONE AT CORNER AS RECORDED
BTS SHOW GOOD WEARS WE
DO NOT OPEN.

SET BRASS CAP ALONGSIDE
COR. STONE A MARK COUNTY
SURVEYORS OFFICE 1961

5/16 5/15 T29S R1W

NEW BTS.
15" R. FIR BRASS N 22° W 150'
SCRIBED 5 10 T29S R1W CS BT

14" R. FIR BRASS N 62° E 32'
SCRIBED 1/4 S 9° S 10' BT

~~G.S. No. 385-6~~

MAY 28 - 1962

* * ○ VAR 20°

J. B. J.P.