

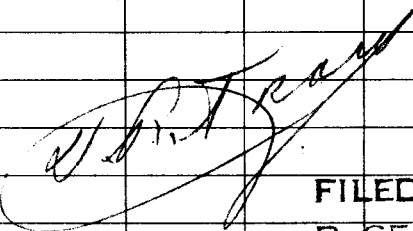
Renew Meander Cor. 55/54 T235 R7W

This cor lies on the Right or North
Bank - we find one B.T. as Recorded
in Rev. #32 as follows -

24" Now 27" D. FIR N. 11° E. 642 FT.
part of BRASS plate & some scribe visible
on partially beaded face. No Trace
S.W. B.T. - orig. BT now STUMP.
We drive $\frac{3}{4}$ " I.R. at cor. point
& it is impracticable to set BRASS
cap at cor. Due to the possibility
of high water. MARK New B.T. -
9" D. FIR N. 31° W. 68 ± FT.
Mkd. " M.C. 55 CS BT "

Dec. 7, 1965

U.R.T.
M.S.
J.L.


FILED
RECEIVED

DEC 7 1965

COUNTY SURVEYOR
DOUGLAS COUNTY, ORE.

#119

C. S. Inc. No. 52/125-16