


RENEW ^{NO. 1} ₂₀ T29S R9W

FOUND - 2' W.D. AT FENCE
COR. THUS.

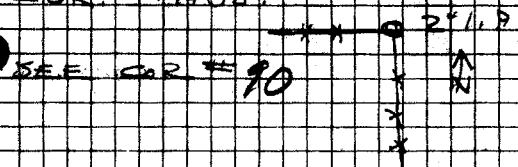

NEW BTJ.

6" LAUREL BEARDS N57°E 70'
SCRIBED S 21 T29S R9W CS BT

4" LAUREL BEARDS S 6°E 246'
SCRIBED S 28 CS BT

7" R. FIR BEARDS S 73°W 52'
SCRIBED S 29 T29S R9W CS BT

No TREES NEAR TO NW.

DIETZGEN NO. 385-S

FILED

APRIL 19-1963

RECEIVED

J. B.
M. D.

APR 19 1963

COUNTY SURVEYOR
DOUGLAS COUNTY, ORE.

+ * ✓

C. S. File No. 52/126-1A