

Review  $\frac{1}{4}$  510/511 T295 R3W

Fd. 1964 Cad. Brass cap properly  
MKd. & Firmly Set. 1964 B.T.S 25  
follows -

12" now 13" FIR N.  $53^{\circ}$  E. 23  $\frac{4}{5}$  ft. (Should be 23  $\frac{1}{2}$ )

2 live - scribe MKs visible on  
partially healed blaze - Note =  
Record Bearing N.  $67^{\circ}$  E.

7" now 8" FIR N.  $84\frac{1}{2}^{\circ}$  W. 81  $\frac{5}{8}$  ft. (Should be 81  $\frac{3}{4}$ )

2 live - scribe MKs visible on  
partially healed blaze - This  
Tree to be Removed for  
cultivation of field. We  
MK. New B.T.

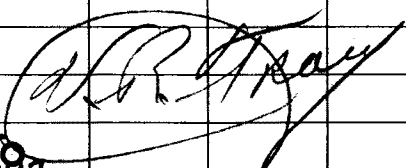
6" D. FIR S. 20  $^{\circ}$  W. 92  $\frac{7}{8}$  ft.  
MKd. "14510CS BT"

This cor. Lies 40 ft East  
of roadway course N. & S.

June 28, 1967

W.R.T.  
J.H.

V.V. Moore witness

  
\* O.K. J.W.B.

C. S. File No. 52/126-150