


RENEW S $\frac{1}{4}$ S6 T30S R3W

FOUND - STONE AT COR ~~SE~~

BOTH BITS AS RECORDED NOW

16' W. O. N65'W 7.3' SHOWS SCRIBING
NE BIT FAIR CONDITION.

FENCES

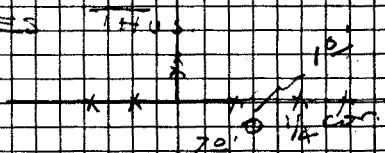

SET BRASS CAP ALONGSIDE COR
STONE. MARK COUNTY SURVEYORS
OFFICE 1953 SOUTH $\frac{1}{4}$ S6 T30S R3W

NEW BIT.

10" W. OAKA ^{IN CLUMP} BEARS S 45° E 50'
SCRIBED $\frac{1}{2}$ S COR.

NOTE - MARKS NOT FOUND ON
COR STONE.

DIETZGEN NO. 388-6

Feb 1963

C. S. File No. 52/138-23