


County

PUBLIC LAND CORNERS #46

WEYERHAEUSER TIMBER COMPANY
SPRINGFIELD BRANCH

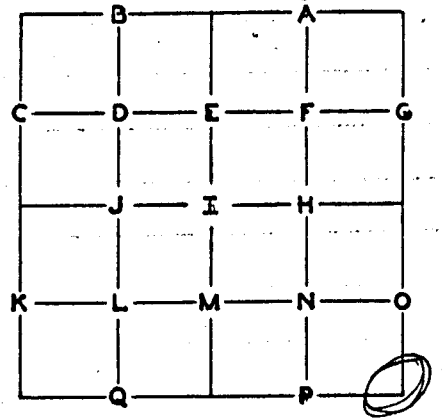

TOWNSHIP 20S RANGE 6W

SECTION 14 CORNER SE

COUNTY Lane OREGON

GLO SURVEY RECORD

CORNER POST DATE: 1872

PRESENT CONDITION - (DESCRIBE FULLY - USE PAGE 2 IF NEEDED FOR EXPLANATION.)

No Trace

ACCESSORIES:

	BEARING-	LINKS-	FEET-	
<u>7" Fir</u>	<u>N35°W</u>	<u>15</u>	<u>9.9</u>	<u>No trace - destroyed by logging.</u>
<u>1/4" Fir</u>	<u>S55°W</u>	<u>15</u>	<u>9.9</u>	<u>Now 19" Fir Snag. Scribed "523" visible.</u>
<u>8" Fir</u>	<u>S12 1/2°E</u>	<u>29</u>	<u>19.1</u>	<u>Destroyed by logging. No trace.</u>
<u>No Tree</u>	<u>Convenient</u>	<u>Sec</u>	<u>12</u>	

SURVEY RECORD
DATE:

PRESENT CONDITION:

CORNER SET: 5/8" Monel Pipe

MAG. DECL: 20°

BEARING AND DISTANCE TO ABOVE IDENTIFIED SURVEY ACCESSORIES:

BEARING-	FEET-	SURVEY -	
<u>S55°W</u>	<u>9.9</u>	<u>GLO</u>	<u>19" Fir Snag.</u>

CS 53/1-4
(A)

ACCESSORIES ADDED THIS DATE:

MAGNETIC DECLINATION

File 1316
20°

	BEARING	FEET	ORIG. B.T.	"W" NAIL	PLATE	BRASS DISC
46" Fir Snag	S 7 W	21.6		X	X	
42" Fir Stump	N 17 W	16.8		X	X	
36" Fir	S 64 W	30.5		X	X	
Referenced only 3 Trees						

IDENTIFIED ON PHOTO:

INFORMATION ON LOCATION OF CORNER AS NOW SET:

GROUND COVER: *Alder, Sals, Skunk Cabbage.*

(USING FORM LINES SKETCH TOPOG AT CORNER ON PAGE 2 PLAT)

SLOPE FACES (GIVE BEARING IN DEGREES) *S 65 E* ON MINUS (-) *15 %*

FROM CORNER -

NORTH: *+29°*. 4' to Creek 1' Wide C-565E. 1170' to Wit. Co. Plate on Post N side dirt road. Logged to East and West.

SOUTH: *-4°*. Logged to East, Timbered to West.

EAST: *-8°*. 7' Cr. 1' Wide C-565E. Logged both Sides line.

WEST: *+32°*. Logged to North, Timbered to South.

WORK DONE FOR W. T. CO.:

FIELD NOTES IN BOOK:

BY: *Glen McChesney* DATE: *4/17/58*
ENGINEER - SURVEYOR

UNDER THE SUPERVISION OF:

ASSISTED BY: *Bob Barte*

COPIES SENT TO:

SEAL

PAGE 3

CS 53/1-4
(B)