

LANE COUNTY RESTORED CORNER

Index 2214

Corner Corner common to Section 18/19, 13/21

Twp. 20 S R. 6 W & 7 W

From original G. L. O. field notes, dated _____ EVIDENCE FOUND: _____, 19____

Corner _____

Witness _____

Marks _____

From reestablishment field notes, dated _____ EVIDENCE FOUND: Now 48" R. Fir faces S.82°W., 19____


Corner scribed about 15 years ago. (S18) Also find 48" Fir Snag faces N.45°W., seems to have been scribed by same person who scribed SW. BT. The N.W. Tree scbd. S19, using record distance & bearing from S.W. BT. (S82°W. 23.1'

Witness The BT. to North is N.05°E., record N 05°E. 39.6 ft. distance, checks O.K.

Marks _____

RETRACEMENT NOTES: I measure 153 ft. (record 193.4 ft) & find Stake, not marked, from which I find splinter of Cedar Stump that shows good scribing "R7W SB". I believe this scribing was made about 2 to 4 years ago

*Investigation only -
no renewal*

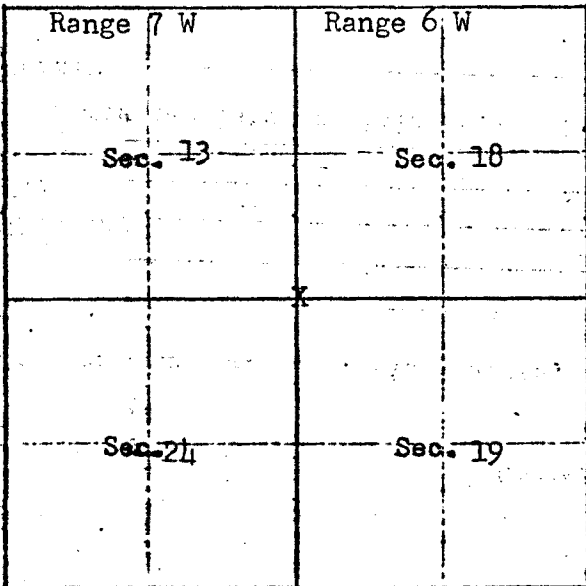

James W. Byron
Signature

1958
Date

Deputy County Surveyor
Title

Douglas County Surveyor's Office

CS 5311-6