

*Not considered as renewal*

LANE COUNTY RESTORED CORNER

Index 2689

Corner Southeast corner Section 22

Twp. 20 S R. 6 WEST

From original G. L. O. field notes, dated 1950

EVIDENCE FOUND: June 19, 19 61

Corner Brass Cap

Found

26" Fir North 60 1/2° East 78 links

28" Fir O.K.

Witness 26" Fir South 37 1/2° East 101 links

30" Fir O.K.

Marks 20" Fir South 70 1/2° West 33 links

26" Fir O.K.

22" Fir North 48 3/4° West 67 links

26" fir O.K.


From reestablishment field notes, dated \_\_\_\_\_

EVIDENCE FOUND: \_\_\_\_\_, 19 \_\_\_\_\_

Corner \_\_\_\_\_

Witness \_\_\_\_\_

Marks \_\_\_\_\_

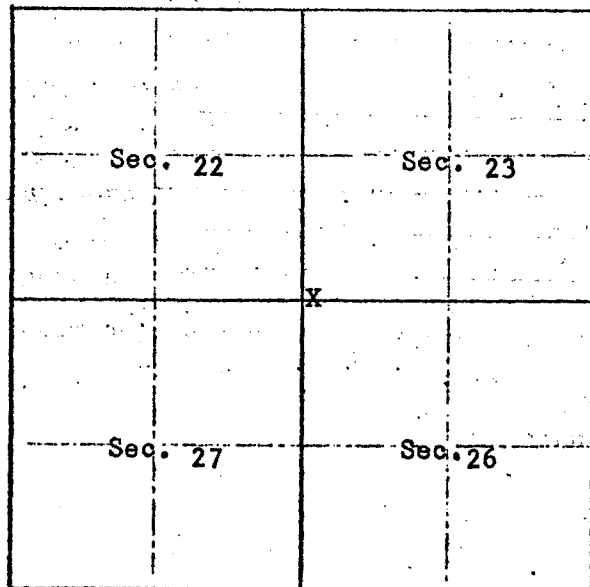

RETRACEMENT NOTES:

Plates, "W" nails, 20° Declination

28" Fir South 59° East 51.0 feet

30" Fir South 38° East 65.7 feet

26" Fir South 69° West 20.2 feet

26" Fir North 49° West 42.4 feet

William L. Wilt

Signature

7/12/61

Date

Land Agent

Title

85-028-01

*CS 53/1-7*