

see Cor #38

LANE COUNTY RESTORED CORNER

Index 2690

Corner Southwest corner Section 22

Twp. 20 S R. 6 WEST

From original G. L. O. field notes, dated 1950

EVIDENCE FOUND: June 20, 19 61

Corner Brass Cap

Found

13" Fir North 48° East 39 links

32" Fir O.K.

Witness 42" Fir South 86½° East 120 links

Gone - destroyed by logging

Marks 60" Fir South 53° West 119 links

Now stump - scribing visible

24" Fir North 30 3/4° West 53 links

Removed in road construction


From reestablishment field notes, dated _____

EVIDENCE FOUND: _____, 19 _____

Corner _____

Witness _____

Marks _____

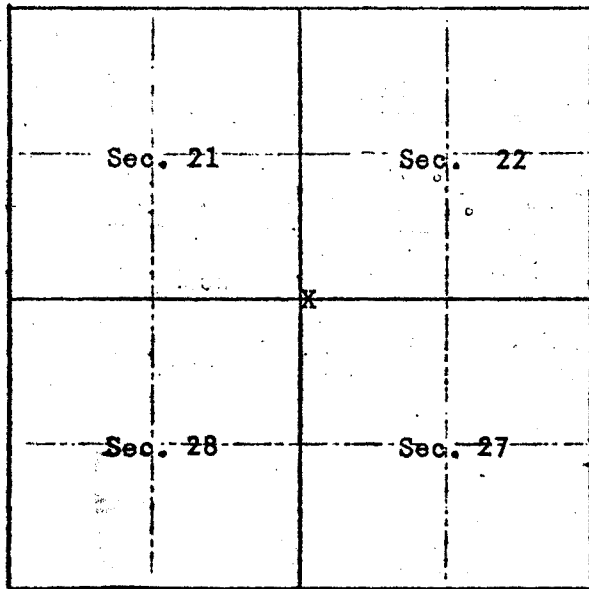

RETRACEMENT NOTES:

Plas, "W" nails, 20° Declination

32" Fir North 49° East 33.4 feet

16" Fir South 72° East 23.4 feet

44" Fir stump South 52° West 77.3 feet

48" Fir North 30° West 76.3 feet

William L. wilt

Signature

7/13/61

Date

Land Agent

Title

CS 53/1-8