

#48

LANE COUNTY RESTORED CORNER

Index 2691

Corner South one-quarter corner Section 22 Twp. 20S R. 6 WEST

From original G. L. O. field notes, dated 1950

EVIDENCE FOUND: June 19, 19 61

Corner Brass Cap

Witness 32" Hemlock North 7½° West 82 links

Marks 40" Cedar South 44½° West 9 links

Good Condition

Good Condition


From reestablishment field notes, dated _____

EVIDENCE FOUND: _____, 19 _____

Corner _____

Witness _____

Marks _____

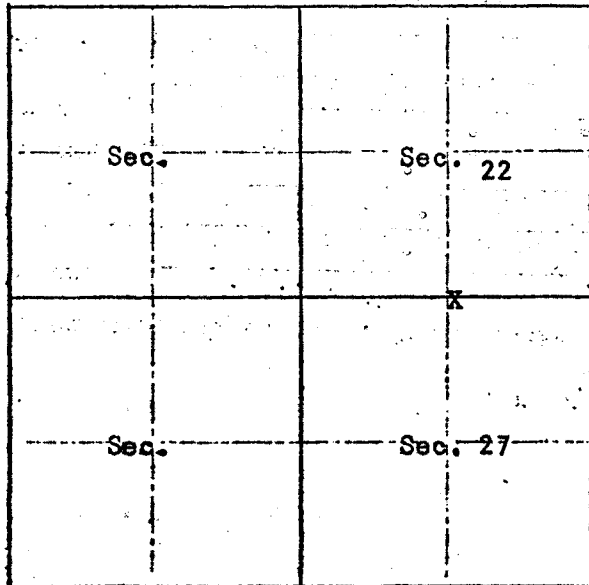

RETRACEMENT NOTES: _____

Plates, "W" nails 20° Declination

44" Cedar North 56° East 37.5 feet

40" Cedar South 44° West 5.0 feet

William L. Wilt

Signature

7/13/61

Date

Land Agent Weyer Co.

Title

✓ O.
CS 53/1-9