

For Douglas Co. Surveyor

U. S. Department of Agriculture
FOREST SERVICE

Siuslaw NATIONAL FOREST

CORNERS OF THE PUBLIC SURVEY

T. 19 S R. 10 W Will. Mer.

Section Corner common to Sections

11, 12, 13, and 14

Corner consists of a iron pipe (old well point) in place



State condition fair

Dimensions above ground 1 1/2" x 18" inches.

Sketch grooves, letters, figures, or notches, on proper face or edge.

SPINE CORNERS

METAL CORNERS

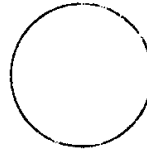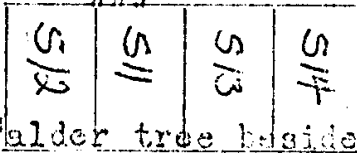


20" alder tree beside pipe

NE NW SE SW

Mound of _____ is located _____

Pits are located _____

Sketch markings of Bearing Trees (or Rocks) in proper box and fill blanks below, giving bearings from Corner to Trees and Distances in Links.

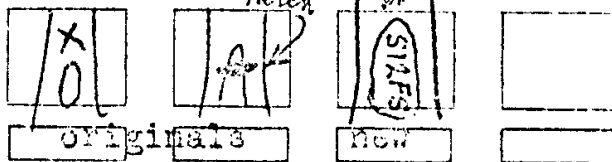

Species	fir	fir	fir
Diameter	50"	36"	26"
Bearing	S 38° E	S 8° W	N 31° E
Distance	87 lks	56 lks	67 ft.

Do you believe this to be a genuine Land Office Corner? ...
If not, why? pipe was set by me with reference to the original SE & SW BT's.
See reverse side.

Alan D. Reid
(Signature)

9/19/58
(Date)

Forester
(Title)

#12

LANE COUNTY RESTORED CORNER

Index 2183

Corner Section corner 11, 12, 13, 14 T 19 S R 10 W

From G.L.O. Notes dated: _____ Evidence Found: Sept 19, 19 58
 Corner I find the original SE & SW BT's for this ~~corner~~ corner. At the indicated position for the tree corner is an old rotten stump with a 20" alder beside it on the South. At the Witness position for the NE BT is another alder, badly broken and rotted. There is not sign Marks of the NW hem BT except a rotted stump. Corner is at the head of a ravine to the NE, in large alder area. Corner is about 4 ch. E of N-S spur ridge top, about 8 ch N of Reestablishment Notes dated E-W spur ridge. Evidence Found _____, 19 _____
 Corner _____ Corner _____

Witness _____
 Marks _____

11		12	
14		13	

Restoration Notes: At corner point indicated by the remaining BT's I drive an old iron well point, 1 1/2"x30", 18" above ground, under a 2' bank. This is beside the North edge of a 20" alder which I bark scribe; on the NE - S12, on the NW - S11, on the SE - S13, on the SW - S14.
26" fir, scribed S12FS, N33°30'E, 92 lks.


State Coordinates N = _____ S = _____

Signature Alan D. Reid

Date 9/19/58 Title Forester

(Use back of card for diagram)

12

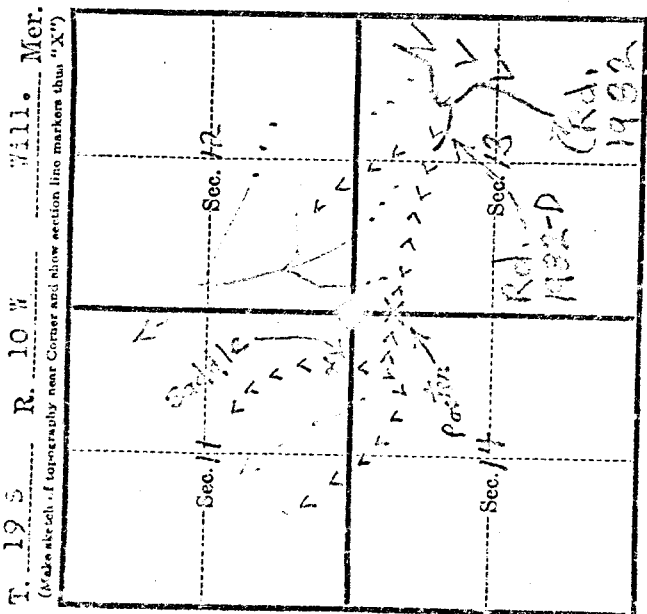

Metal Location Poster is on a fir tree 8 inches diameter, on the North side of the main spur ridge this Corner bears North, 2 (Distance) Chaisas. Section line marker between Secs. _____ and _____ is on a _____ (Tree, post, etc.) located _____ chains N. W. S., from Sec. Cor., 1/4 Sec.; Wilcox Cor. (Cross out nonapplicable) Give any further facts needed to find Corner again: There are alder trees at the location of the corner and the NE original BT. There are no signs of the original markings on these, but they have the appearance of being sprouts from the broken stumps of the original trees. Pipe driven on the North side of the corner tree, Pipe hidden by being under a 2 ft. bank.

*Copy from Gardner
 Ranger Dist. U.S.F.S.
 Steve Waite
 I.P. Co.*