


# PUBLIC LAND CORNERS

WEYERHAEUSER TIMBER COMPANY  
 SPRINGFIELD BRANCH

TOWNSHIP 23 S RANGE 3 W  
 SECTION 18 CORNER SW  
 COUNTY LANE OREGON

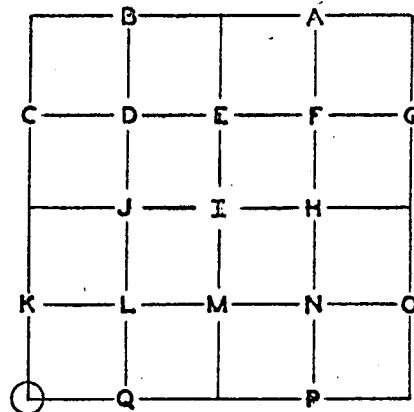

GLO SURVEY RECORD  
 1882  
 VINE DATE 6" Dia.  
 CORNER \_\_\_\_\_

PRESENT CONDITION - (DESCRIBE FULLY -  
 USE PAGE 2 IF NEEDED FOR EXPLANATION.)  
 Vine Maple alive & in fair condition  
 considering the number of inscribed  
 cruisers marks.

ACCESSORIES:

	BEARING-	LINKS-	FEET-
48" Fir	S 50° E	12	7.9
6" Vine Map	S 50° W	30	19.8
6" Vine Map	N 10° W	25	16.5
30" Fir	N 65° E	33	21.8

*Scribe on bank mostly visible m.o.Hab*  
 Brng. should read N50°E, now 50" Fir  
*scribing visibly on bank*  
 Vine Maple gone  
 found rotted on ground  
 Brng. should read S65° E, now stump,  
 found ~~no~~ scribing.  
*Some*

SURVEY RECORD  
 DATE: \_\_\_\_\_

PRESENT CONDITION: \_\_\_\_\_

CORNER SET: 6" Vine Maple MAG. DECL: 20° E

BEARING AND DISTANCE TO ABOVE IDENTIFIED SURVEY ACCESSORIES:

BEARING-	FEET-	SURVEY -	
N 48° E	8.0	Orig.	To orig. 48" Fir S50° E (incorrect)
S 65° E	21.8	Orig.	Stump - recorded N 65° E

CS 53 / 1-20  
 A

1312

ACCESSORIES ADDED THIS DATE:

#26

MAGNETIC DECLINATION

20° E

	BEARING	FEET	ORIG. B.T.	"W" NAIL	PLATE	BRASS DISC
48" Fir	S 88° E	37.2		x	x	
50" Fir	N 48° E	8.0	x	x	x	
54" Fir	N 66° W	25.9		x	x	
17" Hemlock	S 34° W	32.7		x	x	

IDENTIFIED ON PHOTO:

INFORMATION ON LOCATION OF CORNER AS NOW SET:

GROUND COVER: OG Fir, Hemlock, Vine Maple and ferns

(USING FORM LINES SKETCH TOPOG AT CORNER ON PAGE 2 PLAT)

SLOPE FACES (GIVE BEARING IN DEGREES) \_\_\_\_\_ ON MINUS (-) \_\_\_\_\_ %

NORTH: \_\_\_\_\_

SOUTH: \_\_\_\_\_

EAST: \_\_\_\_\_

WEST: \_\_\_\_\_

FROM CORNER |

WORK DONE FOR W. T. CO.:

FIELD NOTES IN BOOK: \_\_\_\_\_

BY: Marvin W. Hale DATE: 3/14/57  
ENGINEER - SURVEYOR

UNDER THE SUPERVISION OF:

ASSISTED BY: D. Warner

G. Waller

COPIES SENT TO: \_\_\_\_\_

SEAL

PAGE 3

CS 53/1-20  
8