

PUBLIC LAND CORNERS

Index 1319


#27 ✓

WEYERHAEUSER TIMBER COMPANY
SPRINGFIELD BRANCH

TOWNSHIP 235 RANGE 3W

SECTION 18 CORNER W 1/4

COUNTY Lane-Douglas Line OREGON

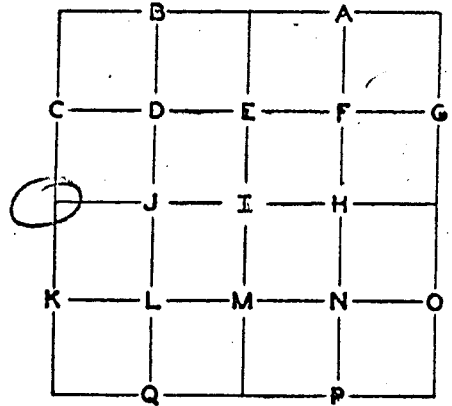

GLO SURVEY RECORD

DATE: 1882
CORNER 50" Fir Scribed West Face

PRESENT CONDITION - (DESCRIBE FULLY - USE PAGE 2 IF NEEDED FOR EXPLANATION.)

Found bark scribed "1/4" West Face of 60" Fir.

ACCESSORIES:

	BEARING-	LINKS-	FEET-	
<u>8" Yaw</u>	<u>S 40 W</u>	<u>25</u>	<u>16.5</u>	<u>10" Yaw broken 4' high; dead. Scribing Dist. etc.</u>
<u>40" Fir</u>	<u>N 10 E</u>	<u>30</u>	<u>19.8</u>	<u>46" Fir. Axemarks not chopped. Possibly was bark scribed, flaked off.</u>

SURVEY RECORD

DATE: _____

PRESENT CONDITION: _____

CORNER SET: 5/16 Iron rod in West Foot-Swell of MAG. DECL: 20°

60" Corner Fir. Base of rod is 6" West of bark scribing.

BEARING AND DISTANCE TO ABOVE IDENTIFIED SURVEY ACCESSORIES:

BEARING-	FEET-	SURVEY -	
<u>S 18 1/2 W</u>	<u>23.0</u>	<u>GLO</u>	<u>Dist + bear taken to Scribing on W face Cor. Fir. To scribed Yaw.</u>
<u>N 6 W</u>	<u>19.8</u>	<u>GLO</u>	<u>From Scribing on West Face Cor. Fir to 46" Fir. GLO bearing probably should be N 10 W instead of N 10 E</u>

PAGE 1

CS 53/11-21
A-

ACCESSORIES ADDED THIS DATE: #27 ✓

MAGNETIC DECLINATION

1314
20°

	BEARING	FEET	ORIG. B.T.	"W" NAIL	PLATE	BRASS DISC
56" Fir	N22E	35.0		X	X	
48" Fir	S46W	31.0		X	X	

IDENTIFIED ON PHOTO:

INFORMATION ON LOCATION OF CORNER AS NOW SET:

GROUND COVER: Sword Fern

(USING FORM LINES SKETCH TOPOG AT CORNER ON PAGE 2 PLAT)

SLOPE FACES (GIVE BEARING IN DEGREES) S20E ON MINUS (-) 8 %

NORTH: +390

SOUTH: -590

EAST: -390 75'; -2090

WEST: -290 60'; +3290 100'

FROM CORNER -

WORK DONE FOR W. T. CO.:

FIELD NOTES IN BOOK: _____

BY: Alvin McCaskey
ENGINEER - SURVEYOR

DATE: 4-1-58

UNDER THE SUPERVISION OF:

ASSISTED BY: _____

COPIES SENT TO: _____

SEAL

PAGE 3

CS 53 / 11-21

B