


# PUBLIC LAND CORNERS

index 1315

#28

WEYERHAEUSER TIMBER COMPANY  
SPRINGFIELD BRANCH

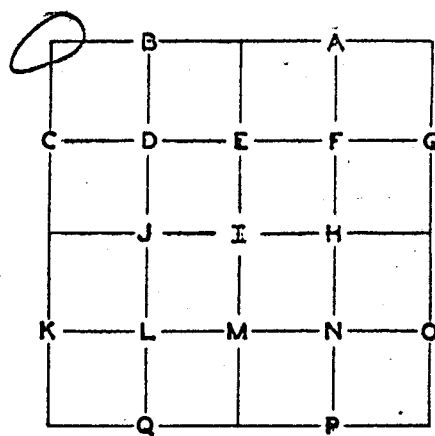

TOWNSHIP 23S RANGE 3W

SECTION 18 CORNER NW

COUNTY Lane-Douglas Line OREGON

**GLO SURVEY RECORD**

CORNER Post DATE: 1855

PRESENT CONDITION - (DESCRIBE FULLY - USE PAGE 2 IF NEEDED FOR EXPLANATION.)

No Trace

**ACCESSORIES:**

	BEARING-	LINKS-	FEET-	
<u>15" Cedar</u>	<u>N50W</u>	<u>45</u>	<u>29.7</u>	<u>26"X15' Stub, badly burned, No scribing visible.</u>
<u>8" Cedar</u>	<u>S68W</u>	<u>37</u>	<u>24.4</u>	<u>No trace.</u>
<u>12" Cedar</u>	<u>S55E</u>	<u>12</u>	<u>7.9</u>	<u>38" Cedar, Faces not chopped.</u>
<u>86" Fir</u>	<u>N50E</u>	<u>19</u>	<u>12.5</u>	<u>86" Fir, Bark scribing visible.</u>

SURVEY RECORD  
DATE:

PRESENT CONDITION:

CORNER SET: By dist'n bearings from NW and SE MAG. DECL: 20°

GLO BT's.

**BEARING AND DISTANCE TO ABOVE IDENTIFIED SURVEY ACCESSORIES:**

BEARING-	FEET-	SURVEY -	
<u>N50W</u>	<u>29.7</u>	<u>GLO</u>	<u>Cedar Stub</u>
<u>S</u>			
<u>S55E</u>	<u>7.9</u>	<u>)</u>	<u>38" Cedar</u>
<u>N57E</u>	<u>12.0</u>	<u>)</u>	<u>86" Fir</u>

CS 53/1-22  
A

1315

#28 ✓

ACCESSORIES ADDED THIS DATE:

MAGNETIC DECLINATION 20°

	BEARING	FEET	ORIG. B.T.	"W" NAIL	PLATE	BRASS DISC
52" Fir Stamp	N5E	51.8		X	X	
86" Fir	N61E	12.0	X	X	X	
38" Cedar	S54E	6.6	X	X	X	
12" Cedar	S51W	32.0		X	X	

IDENTIFIED ON PHOTO:

INFORMATION ON LOCATION OF CORNER AS NOW SET:

GROUND COVER: Sward fern + Oregon grape, Old blowdown.

(USING FORM LINES SKETCH TOPOG AT CORNER ON PAGE 2 PLAT)

SLOPE FACES (GIVE BEARING IN DEGREES) N25W ON MINUS (-) 32 %

FROM CORNER -

NORTH: -32% 80' stream CN55W, Logged to East and West.

SOUTH: +60% Old growth to East and West.

EAST: +20% 135' stream CN54W, 520' to Summit Calapoya Mtns. Logged to North, Old growth to South.

WEST: -8% Logged to North, old growth to South.

WORK DONE FOR W. T. CO.:

FIELD NOTES IN BOOK:

BY: Glen McChesney ENGINEER - SURVEYOR DATE: 4-1-58

UNDER THE SUPERVISION OF:

ASSISTED BY:

COPIES SENT TO:

SEAL PAGE 3

CS 53/1-22  
B