

LANE COUNTY RESTORED CORNER

Index 2025

Corner North 1/4 Corner Section 28

Twp. 23 S R. 3W

From original G. L. O. field notes, dated 1882

EVIDENCE FOUND: March, 19 59

Corner 5" hem

Gone

Witness 8" fir East 10 lks

Gone

Marks 4" fir N80°E 12 lks

Gone

From reestablishment field notes, dated _____

EVIDENCE FOUND: _____, 19 _____

Corner _____


Witness _____

Marks _____

RETRACEMENT NOTES: Set 1/2" x 35" GIP for corner by single proportionate method.

Referenced:

18" fir S75°W 7.9'
22" fir N29°W 34.0'

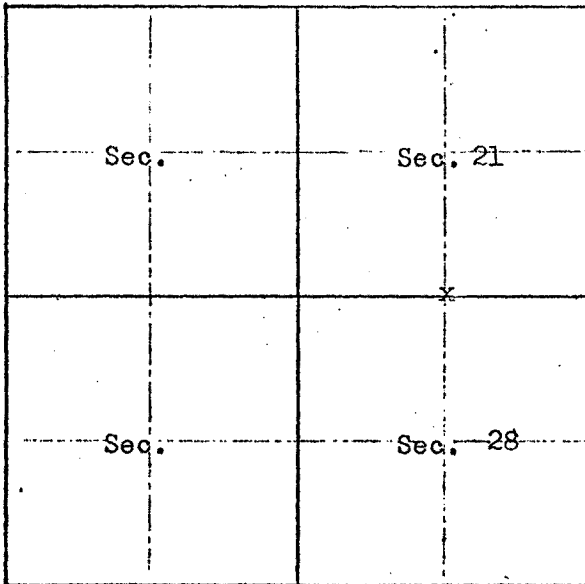

M. D. Hale

Signature

July 13, 1959

Date

Surveyor, WTCO.

Title

CS 53/1-25