

LANE COUNTY RESTORED CORNER

Index 2026

Corner Northwest Corner Section 28

Twp. 23S R. 3W

From original G. L. O. field notes, dated 1882  
 Corner 24" fir  
5" hem N30°E 15 lks  
 Witness 6" hem S60°E 6 lks  
 Marks 6" hem S45°W 8 lks  
10" hem N15°W 32 lks


From reestablishment field notes, dated Gardner 1954  
 Corner 24" fir N86°W 23.0'  
24" fir S34°W 18.5'  
 Witness 18" fir S41°E 28.0'  
 Marks 20" fir N33°E 24.0'

EVIDENCE FOUND: March 25, 1959  
14"x2' high rotten fir stump. found scribe for Sec. 28  
Gone  
Gone  
Gone  
Found root holes

EVIDENCE FOUND: March 25, 1959  
23" fir scribed S20 BT  
23" fir scribed S29 BT  
20" fir scribed S28 BT  
26" fir scribed S21 BT

RETRACEMENT NOTES: Set 1/2" x 35" GIP driven down center of rotten stump for corner.

Referenced:  
20" fir S41°E 28.0'  
23" fir S34°W 18.6'  
40" fir N62°E 64.3'  
26" fir N66°W 51.4'

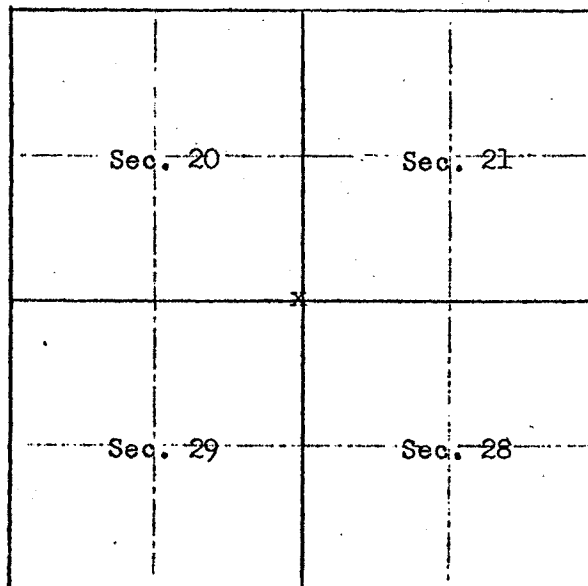

M. D. Hale  
 Signature

July 13, 1959  
 Date

Surveyor, WTCO.  
 Title

CS 53/1-26