

LANE COUNTY RESTORED CORNER

Index 2027

Corner Southwest Corner Section 28

Twp. 22S R. 3W

From original G. L. O. field notes, dated 1856

EVIDENCE FOUND: June 17, 19 59

Corner Post

Gone

30" fir N31°E 30 lks

Burned out stub, found scribing on bark

Witness 24" fir S51°W 270 lks

Badly burned and rotted tree on ground

Marks 18" fir N05°E 30 lks

Found roots burned off at ground line

18" fir N79°W 426 lks

Badly burned and rotted stump


From reestablishment field notes, dated _____

EVIDENCE FOUND: _____, 19 _____

Corner _____

Witness _____

Marks _____

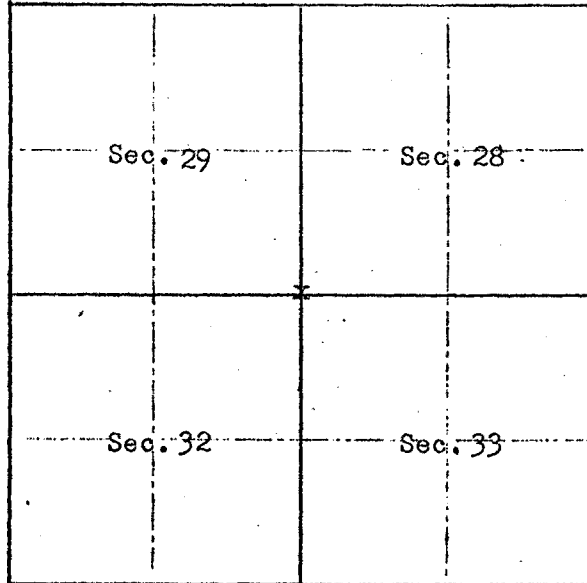

RETRACEMENT NOTES: Set 3"x3"x3½' fir post

Referenced: _____

14" fir S60°E 31.8'

16" fir S16°W 32.2'

16" fir N79°E 5.6'

26" W fir North 29.7'

Lyle E. Boustead

Signature

July 13, 1959

Date

Land Agent, WCo.

Title

CS 53/1-27

85-028-01