

LANE COUNTY RESTORED CORNER

Index 2029

Corner Northeast Corner Section 5

Twp. 20S R. 4W

From original G. L. O. field notes, dated 1854

Corner Post

18" R fir N31°E 93 lks

Witness 36" fir N22°W 98 lks

Marks 40" redwood S70°W 10 lks

48" redwood S50°E 12 lks

From reestablishment field notes, dated 1958

Corner Brass cap

40" I cedar N52°E 74.5'

Witness 12" fir S32°E 81.9'

Marks 16" fir N61½°W 151.0'

EVIDENCE FOUND: May 12, 19 59

Gone

32" blow down, chopped out, scribing vis.

badly rotted stump

down - badly burned.

Gone

EVIDENCE FOUND: May 12, 19 59

Found

OK

OK

OK


RETRACEMENT NOTES: _____

Referenced: _____

40" I cedar N52°E 74.5'

12" fir S32°E 81.9'

16" fir N61½°W 151.0'

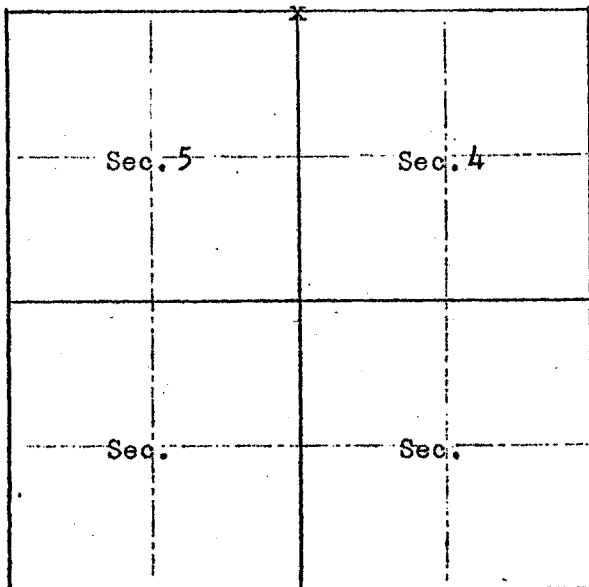

Lyle E. Boustead

Signature

July 13, 1959

Date

Land Agent, WTCO.

Title

85-028-01

CS 53/1-28