

LANE COUNTY RESTORED CORNER

Index 2031

Corner East $\frac{1}{4}$ Corner Section 28


Twp. 23S R. 3W

From original G. L. O. field notes, dated 1882
 Corner 5" hem
5" hem East 18 lks
 Witness 6" hem West 30 lks
 Marks _____

EVIDENCE FOUND: March, 19 59
Not found
Not found
Not found

From reestablishment field notes, dated _____
 Corner _____
 Witness _____
 Marks _____

EVIDENCE FOUND: _____, 19 _____

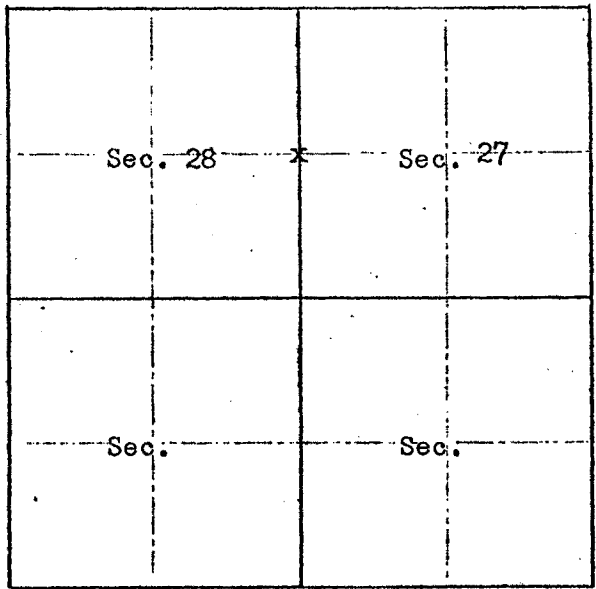

RETRACEMENT NOTES: Set $\frac{1}{2}$ " x 35" GIP by single proportionate method

Referenced:
30" hem stump S16°W 53.3'
36" cedar stump S9°E 132.0'

M. D. Hale
 Signature

July 13, 1959
 Date

Surveyor, WCo.
 Title

CS 53/1-29