

LANE COUNTY RESTORED CORNER

Index 2034

Corner West $\frac{1}{4}$ Corner Section 28

Twp. 23 S R. 3W

From original G. L. O. field notes, dated 1882

EVIDENCE FOUND: March 31, 19 59

Corner Post

Gone

24" hem S40°W 50 lks

found partial face, scribing gone, mostly destroyed during logging.

Witness _____

Marks 24" fir N10°E 75 lks

Gone

From reestablishment field notes, dated _____

EVIDENCE FOUND: _____, 19 _____

Corner _____

Witness _____


Marks _____

RETRACEMENT NOTES: Set $\frac{1}{2}$ " x 34" GIP

Referenced:

39" hem stump S70°E 65.5'

30" cedar stump N75°W 43.6'

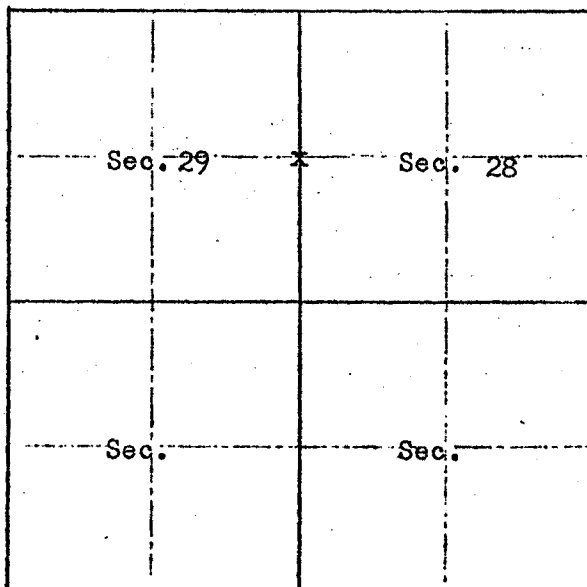

M. D. Hale

Signature

July 13, 1959

Date

Surveyor, WTCO.

Title

CS 53/1-30