

LANE COUNTY RESTORED CORNER

Index 2035

Corner West 1/4 Corner Section 28

Twp. 22S R. 3W

From original G. L. O. field notes, dated 1856

Corner Post

48" fir S16°E 20 lks

Witness _____

Marks 18" hem S61°W 15 lks

From reestablishment field notes, dated _____

Corner _____

Witness _____

Marks _____

EVIDENCE FOUND: June 18, 19 59

Gone

60"x5' stump. Many old axd marks in bark. Could not make out any scribing.

Badly rotted stump 1' high, shopped out and found scribing "BT"

EVIDENCE FOUND: _____, 19 _____


RETRACEMENT NOTES:

Set 2"x2"x3 1/2' yew post

Referenced:

8" fir N78 1/2°W 10.2'

8" fir S36 1/2°E 11.2'

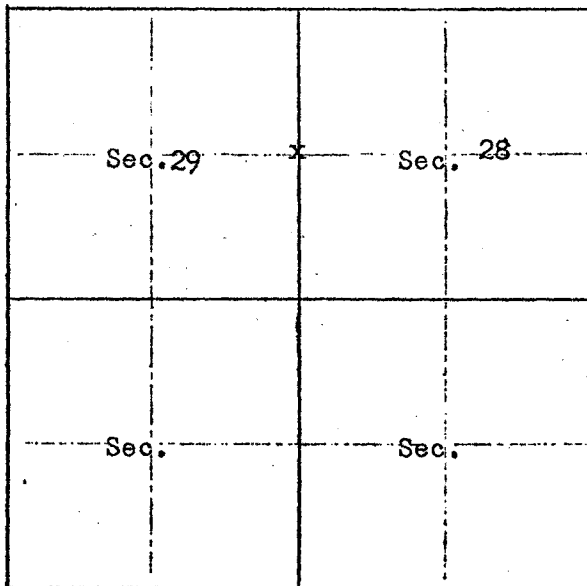

Lyle E. Boustead

Signature

July 13, 1959

Date

Land Agent, WCo.

Title

85-028-01

CS 53/1-31