

#30 ✓

LANE COUNTY RESTORED CORNER

Index 2298

Corner North quarter corner section 26

Twp. 23 S R. 3 W

From original G. L. O. field notes, dated 1882

Corner 4" Chinquapin

Witness 60" Fir South 30° East 15 links

Marks 40" Fir North 13° West 55 links

From reestablishment field notes, dated _____

Corner _____

Witness _____

Marks _____

EVIDENCE FOUND: January 11, 19 60


7" Chinquapin-leaning-no scribing
visible, rotted off. Some cruisers marks
O.K. scribing on back.

No trace of tree

EVIDENCE FOUND: _____, 19 _____

RETRACEMENT NOTES: Set 1/2" x 35" G.I. Pipe in notch at base of leaning
chinquapin for corner. "W" nails, plates 20° declination

58" Fir South 23° East 9.2 feet Orig. B.T.
50" Fir North 67° East 52.4 feet

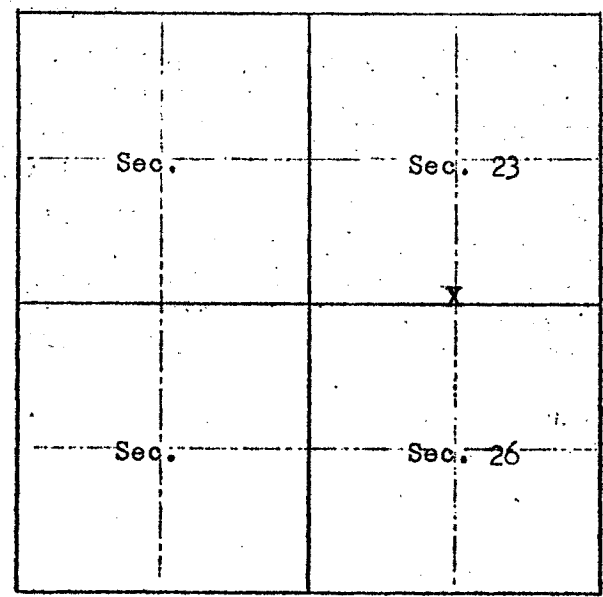

M.D. Hale

Signature

2/19/60

Date

Surveyor

Title

85-028-01

CS 53/1-32