

2037

14	13
23	24

Corner common to Sections 13, 14, 23 and 24-23S-3W

GLO Survey Record.

Post		Gone
30" Fir	N 10° E 40 lks	Found 40" Red Cedar. Scribing visible.
50" Fir	S 75° E 50 lks	Now 68" - No scribing visible. Probably was bark scribed.
24" Cedar	S 65° W 23 lks	Now 54". Scribing visible.
24" Fir	N 35° W 55 lks	Now 32" stub with old cruiser mark "K". No scribing visible.


Found 4" x 4" x 4' Yew post for corner.

Referenced by Glen McChesney (Plates and "W" nails only).
Declination 20°

40" Red Ced.	N 10° E	30.0'	(Original BT)
68" Fir	S 73° E	30.6'	(Original BT)
54" Red Ced.	S 70° W	13.2'	(Original BT)
3" Hemlock	N 61° W	5.0'	

WEYERHAEUSER TIMBER COMPANY CORNER REFERENCE METHOD

A "W" nail driven thru the hole in a brass disc, into a notch cut low on a tree, stamped with the Oregon registered land surveyor or professional engineer registration number. An embossed aluminum plate nailed head high on same tree with 8d aluminum nails, with distance and bearing from the "W" nail to the corner stamped on it.

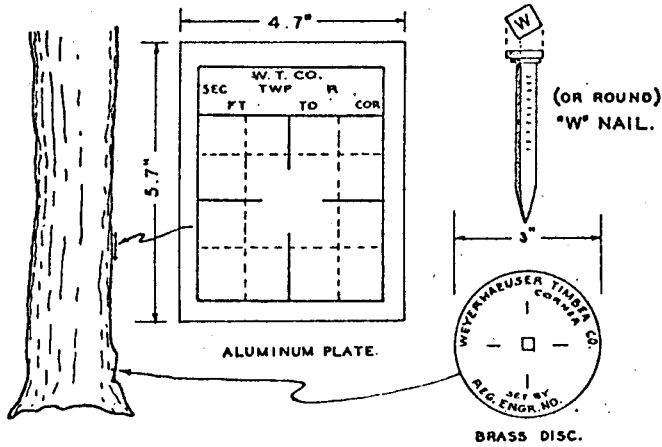

CS 53/1-35