

LANE COUNTY RESTORED CORNER

#34

Index 2605

Corner Southeast Corner of Section 22

Twp. 23 S R. 3 West

From original G. L. O. field notes, dated 1882

EVIDENCE FOUND: February 19, 1959

Corner Post

Gone

6" Fir, North 10° East, 12 links

Gone

Witness 5" Fir, South 20° East, 20 links

24" dead Fir, partly chopped out, no scribing visible.

Marks 7" Fir, South 10° West, 15 links

Gone

6" Fir, North 70° West, 12 links

Gone

From reestablishment field notes, dated Some previous survey


EVIDENCE FOUND: February 19, 1959

Corner 1½" galvanized Iron pipe.

O. K.

Witness \_\_\_\_\_

Marks \_\_\_\_\_

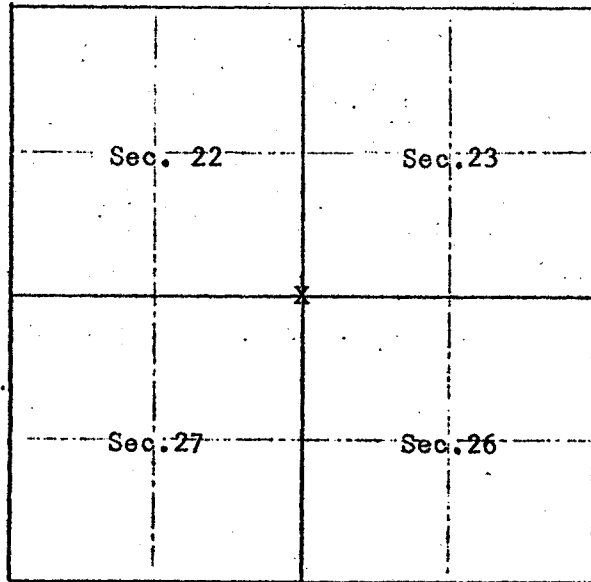

RETRACEMENT NOTES:

"W" Nails and Plates

36" dead Fir, North 42° East, 66.7 feet

24" dead Fir, North 86° West, 63.8 feet

28" dead Fir, South 12° West, 6.4 feet

28" dead Fir, North 80° East, 18.2 feet

M. D. Hale

Signature

4/24/59

Date

Surveyor

Title

CS 53/1-36