


Corner East 1/4 Corner Section 6 T 23 S R 3 W
 From G.L.O. Notes dated: 1859 Evidence Found: _____, 19____
 Corner None stated Corner _____
 Witness 24" Fir S 83° E 100 lks 26" Fir Stump - scribing visible
 Marks 7" Fir West 3 " Gone

Reestablishment Notes dated _____ Evidence Found _____, 19____
 Corner _____ Corner _____
 Witness _____
 Marks _____

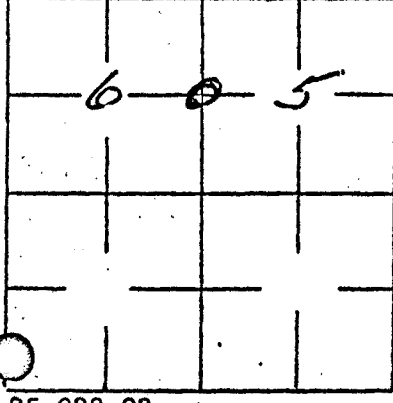

Restoration Notes: set 1" x 30" Aluminum pipe
Plates, "W" nails, 20° Declination
40" Fir S 33° E 6.2'
54" Fir N 19° W 43.1'


State Coordinates N = _____ S = _____
 Signature Glen McChesney
 Date 1-18-62 Title Land Agent Weyerhaeuser Company
 (Use back of card for diagram)

85-028-02

LANE COUNTY RESTORED CORNER

Corner Southeast Corner Section 6 T 23 S R 3 W
 From G.L.O. Notes dated: 1859 Evidence Found: November 6, 1961
 Corner not noted Corner _____
 Witness 4" Maple N 32° E 29 lks Gone
 Marks 8" Dogwood S 06° E 81 " Gone
8" " S 26° W 69 " Gone
48" Fir N 59° W 71 " 48" Fir snag - 2 BLM Tags

Reestablishment Notes dated _____ Evidence Found November 6, 1961
 Corner _____ Corner Found 1 1/4" G.I. pipe and
1/2" I. pipe and Fir post with
4 Beaving Trees set by W.
A. Woodard Lbr. Co. around 1955

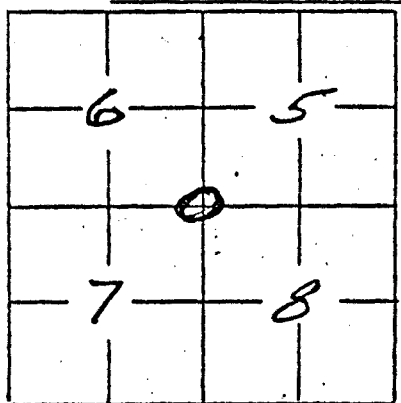

Restoration Notes: Plates, "W" nails, 20° declination
10" Fir N 29° E 11.3'
6" " S 62° E 16.7'
8" " S 54° W 10.2'
10" " N 62° W 1.5'

State Coordinates N = _____ S = _____
 Signature Glen McChesney
 Date 1-18-62 Title Land Agent Weyerhaeuser Company
 (Use back of card for diagram)

85-028-02

CS 53/1-37