


LANE COUNTY RESTORED CORNER

Index 3050

Corner Southwest Corner Section 8 T 23 S R 3 W
 From G.L.O. Notes dated: 1872 Evidence Found: July 16, 1962
 Corner Post Corner Gone
 Witness 6" Maple N 15° E 6 1/2 Gone
 Marks 6" Maple S 75° E 48 1/2 Gone
6" Yew S 75° W 2 1/2 12" yew - scribing visible
30" Fir N 30° W 20 1/2 46" Fir - burned - Truss of bark scribe
 Reestablishment Notes dated 1915 Co. S. Evidence Found: 7-16 1962
 Corner Set Yew Post Corner Found 3" x 3" x 3" old yew post
marked "C.S."
 Witness 10" dead yew N 76° E 41 1/2 Gone
 Marks 10" Forked yew N 65° W 3 1/2 12" Forked yew - old face

Restoration Notes:
Plates, "W" nails; 20° declination
38" Fir N 18° E 25.0'
12" Cedar S 42° E 18.8'
14" Yew S 56° W 4.6'
12" Forked yew N 65° W 1.3'

State Coordinates N= _____ S= _____
7/23/62 Glen McChesney Land Agent
 (Date) (Signature) (Title)
 (use back of card for diagram)

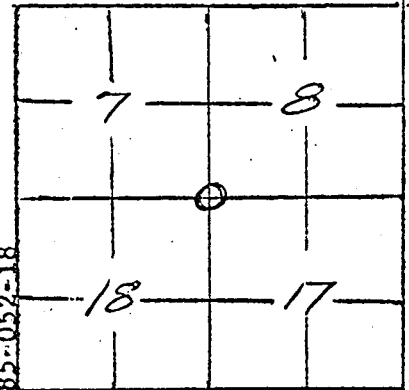

85-052-18


LANE COUNTY RESTORED CORNER

Index 3051

Corner East 1/4 Corner Section 14 T 17 S R 3 E
 From G.L.O. Notes dated: 1884 Evidence Found: July 19, 1962
 Corner Hemlock post Corner Gone
 Witness 15" Chinquapin N 15° E 48 1/2 Gone
 Marks 30" Fir S 45° W 30 1/2 44" Fir windfall - 2 faces
 Reestablishment Notes dated 1951 W. Co. Evidence Found: 7-19 1962
 Corner Set 1 1/2" Iron rod Corner Found this rod bent and painted
22" Fir East 40.9' 22" Fir stump and "w" nail red.
 Witness 40" Fir S 45° W 17.6' 44" Fir down
 Marks 30" Fir stump S 57° W 38.0' 36" Fir stump

Restoration Notes:
Plates, "W" nails and 20° declination:
22" Fir stump S 89° E 40.9'
48" " " N 63° W 51.3'

State Coordinates N= _____ S= _____
7/23/62 Glen McChesney Land Agent
 (Date) (Signature) (Title)
 (use back of card for diagram)

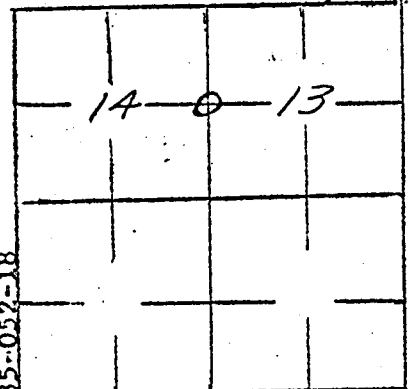

85-052-18

CS 53/1-38