


PUBLIC LAND CORNERS

Index: 121107

**WEYERHAEUSER TIMBER COMPANY
SPRINGFIELD BRANCH**

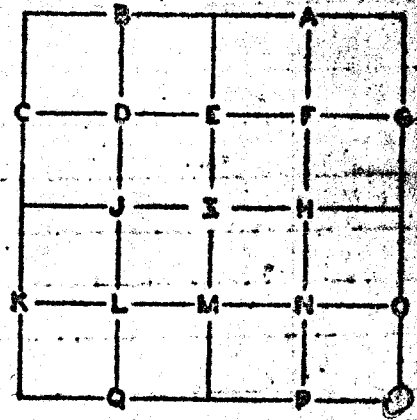

TOWNSHIP 22 S RANGE 4 W
SECTION 2 CORNER SE
COUNTY TANE OREGON

GLO SURVEY RECORD				PRESENT CONDITION - (DESCRIBE FULLY - USE PAGE 2 IF NEEDED FOR EXPLANATION.)
DATE: <u>1855</u>				
CORNER <u>POST</u>				NO TRACE ORIG.
ACCESSORIES:				
BEARING-	LINKS-	FEET-		
12" FIR	S 43° E	29	25.7	SLAB 5" HIGH, WEST OF POST, BEING REPLACING VISIBLY "S12 22S 4W"
10" FIR	N 85° E	24	15.8	POST FIR, NEARLY WIPED BY OLD LOGGING ALUMINUM GANT FROM LOCATION OF BT
4" CEDAR	N 2° W	66	42.5	NO TRACE
8" W. OAK	S 57° W	14	8.2	GROUP OF QUINQUEMARS AROUND QUINQUEMARS BOTTOM SOUTH
SURVEY RECORD				PRESENT CONDITION:
DATE: _____				

CORNER SET: 3" SQ. FIR POST - 177 5/8" W MAGNETIC DECLINATION: 20°
OLD 3" CEDAR POST

BEARING AND DISTANCE TO ABOVE IDENTIFIED SURVEY ACCESSORIES:

BEARING-	FEET-	
S 54° W	8.0	TO CORNER BY QUINQUEMARS
S 43° E	25.7	FIR SLAB - WIPED

PAGE 1
CS 53/1-41

1214

ACCESSORIES ADDED THIS DATE:

	BEARING-	FEET	ORIG. BT	W ² -NAIL	PLATE	BRASS DISC
3" FIR	N 25° W	11.0		x	x	
5" CHINQUAPIN	N 41° E	35.0		x	x	
3" FIR	S 46° E	18.7		x	x	
3.5" FIR	S 13° W	40.6		x	x	

IDENTIFIED ON PHOTO:

INFORMATION ON LOCATION OF CORNER AS NOW SET:

DESCRIPTION OF GROUND COVER AND GROUND SLOPE AT CORNER: GREASEWOODS, SAIAL, CHINQUAPIN SET NO. 5085 - 72 N 35° W

FROM CORNER NORTH: REPROD EAST & WEST, BELONGED TO EAST 1957 -157, 150' -50%

SOUTH: + 8% 30' TO OLD RD.

EAST: + 5% 100' REPROD. AND 95' BELONG TO W. T. CO., RESIDUAL OLD GROWTH TO SOUTH.

WEST: -10% 60', + 5% 100' TO OLD DIRT ROAD

WORK DONE FOR W. T. CO.

BY: _____ DATE: _____
ENGINEER - SURVEYOR

ASSISTED BY: _____

UNDER SUPERVISION OF:

COPIES SENT TO: _____

SEAL PAGE 3

CS 53/i-41
B