


PUBLIC LAND CORNERS

Index: 1216

**WEYERHAEUSER TIMBER COMPANY
SPRINGFIELD BRANCH.**

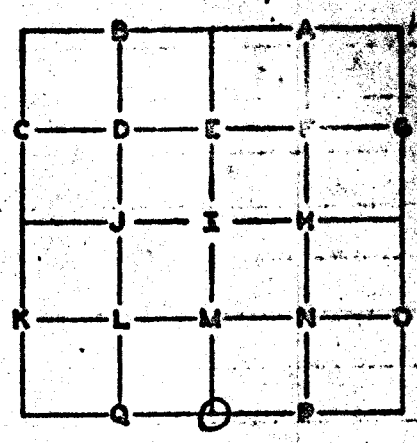

TOWNSHIP 22 S RANGE 11 W
SECTION 12 CORNER S 1/4
COUNTY LANE OREGON

GLO SURVEY RECORD

CORNER _____ DATE: _____

ACCESSORIES:

| | BEARING- | LINKS- | FEET- |
|---------|----------|--------|-------|
| 10" Fir | S 20° W | 20 | 13.2 |
| 8" Fir | N 40° W | 5 | 3.3 |
| | | | |
| | | | |

PRESENT CONDITION - (DESCRIBE FULLY - USE PAGE 2 IF NEEDED FOR EXPLANATION.)

CS SURVEY RECORD

Stone _____ DATE: _____

PRESENT CONDITION: _____

Chiseled CS

CORNER SET: Found Stone Marked CS **MAGNETIC DECLINATION:** 20°

BEARING AND DISTANCE TO ABOVE IDENTIFIED SURVEY ACCESSORIES:

| BEARING- | FEET- | SURVEY - |
|----------|-------|----------------------------------|
| S 88° W | 12.5 | 4 1/2" Fir Scribbled CS 50 years |
| S 60° E | 8.7 | 4 1/2" Fir Scribbled CS 50 years |
| | | |
| | | |

PAGE 1

CS 53/1-42

COPIES ADDED THIS DATE:

MAGNETIC DECLINATION

20⁹

| | BEARING | FEET | ORIG. D.F. | "W" NAIL | PLATE | BRASS DISC |
|---------|---------|------|------------|----------|-------|------------|
| 42" PLT | S 60° E | 8.0 | CS | X | X | |
| 20" PLT | N 56° W | 11.0 | CS | X | X | |
| | | | | | | |
| | | | | | | |

IDENTIFIED ON PHOTO:

INFORMATION ON LOCATION OF CORNER AS NOW SET:

GROUND COVER: Salal

(USING FORM LINES SKETCH TOPOG AT CORNER ON PAGE 2 PLAT)

SLOPE FACES (GIVE BEARING IN DEGREES) S 45° W ON MINUS (-) 15 %

NORTH: 35' Creek flows SE

SOUTH: W 20% 20' + 45% old growth.

EAST: - 10% 100' Creek flows S 10° E - logged to North, timbered to South.

WEST: +25% 60' -20% 150' creek flows NE

WORK DONE FOR W. T. CO.:

FIELD NOTES IN BOOK:

ENGINEER - SURVEYOR

DATE: 1/58

UNDER THE SUPERVISION OF:

ASSISTED BY:

COPIES SENT TO:

SEAL

PAGE 3

CS 53/1-42
B