

PUBLIC LAND CORNERS


Index: 1217

WEYERHAEUSER TIMBER COMPANY
 SPRINGFIELD BRANCH

TOWNSHIP 22 S RANGE 4W

SECTION 14 CORNER NE

COUNTY TANE OREGON

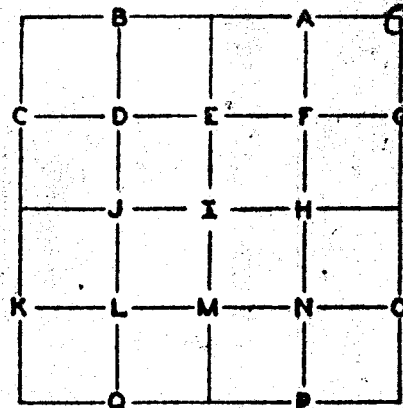

GLO SURVEY RECORD

PRESENT CONDITION - (DESCRIBE FULLY -
 USE PAGE 2 IF NEEDED FOR EXPLANATION.)

DATE: 1855
 CORNER POST

NO TRACE

ACCESSORIES:

	BEARING-	LINKS-	FEET-
66" PIA	S 47° E	5	40.0
66" PIA	S 39° W	95	61.7
40" INCENSE CEDAR	N 57° W	30	19.8
5 PIA	N 37° E	36	19.8

SCALE NOT SHIPPED BY 66" P
 REMAINS REMAINS PIA STAMP
 40" INCENSE CEDAR, SCRAPING VISIBLE
 5 PIA REMAINS, CHINA PIN STAMP

SURVEY RECORD

PRESENT CONDITION:

DATE:

CORNER SET: POINT 1/2" 1/2" ON EOD

MAGNETIC DECLINATION: 20°

BEARING AND DISTANCE TO ABOVE IDENTIFIED SURVEY ACCESSORIES:

BEARING-	FEET-	
N 48° W	47.0	66" PIA ORIGINAL
N 58° W	18.0	40" INCENSE CEDAR

CS 5311-43
 A

ACCESSORIES ADDED THIS DATE:

	BEARING-	FEET	ORIG. BT	W-NAIL	PLATE	BRASS DISC
40" LYONS CEDAR	N 58° W	18.0	x	x	x	
65" FIR	E 49° E	41.2	x	x	x	
12" FIR	E 91° E	54.8		x	x	

IDENTIFIED ON PHOTO:

INFORMATION ON LOCATION OF CORNER AS NOW SET:

DESCRIPTION OF GROUND COVER AND GROUND SLOPE AT CORNER: SALAL, NEARLY LEVEL;
SLOPES S - 3%

FROM CORNER NORTH: + 5% 50' LEVEL RESIDUAL FIR TO EAST, CURRENT LOGGING TO WEST.

SOUTH: - 3% 50', + 10% 50' THEN LEVEL. PLATE ON ROCK ROAD 200' SOUTH OF SECTION CORNER.

EAST: LEVEL RESIDUAL FIR TO NORTH, TO BE LOGGED 1958 TO SOUTH.

WEST: LEVEL LOGGED TO SOUTH, CURRENT LOGGING TO NORTH.

WORK DONE FOR W. T. CO.

BY: _____ DATE: JANUARY 16, 1958
ENGINEER - SURVEYOR

ASSISTED BY: _____

UNDER SUPERVISION OF:

COPIES SENT TO: _____

SEAL PAGE 3

CS 5311-43
B