


# PUBLIC LAND CORNERS

Index: 1218

**WEYERHAEUSER TIMBER COMPANY  
SPRINGFIELD BRANCH**

TOWNSHIP 22 S RANGE 3 W  
SECTION 14 CORNER E 1/4  
COUNTY LANE OREGON

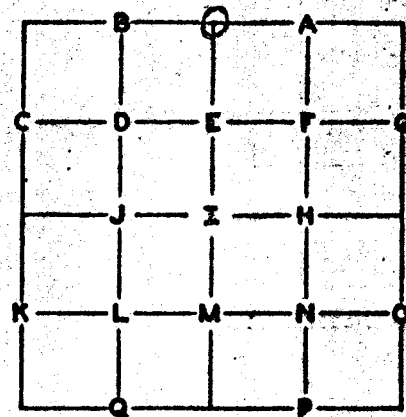

**GLO SURVEY RECORD**

**PRESENT CONDITION - (DESCRIBE FULLY - USE PAGE 2 IF NEEDED FOR EXPLANATION.)**

DATE: 1855  
CORNER POST

NO TRACE ORIGINAL

**ACCESSORIES:**

	BEARING-	LINKS-	FEET-
8" FIR	S 70° W	103	68
LAUREL	N 75° W	2(21)	-

38" FIR, CAPPED OFF, SCRAPING VISIBLE  
WELCH B.M.  
NO TRACE

WTCo SURVEY RECORD  
DATE: JULY 19, 1957

**PRESENT CONDITION:**

8" FIR	N 62° W	16.0
2" INCENSE CEDAR	S 81° W	62.0

WTCO PLATE AND "W" NAIL  
WTCO PLATE AND "W" NAIL

CORNER SET: CEDAR POST MAGNETIC DECLINATION: 20°

FOUND IN PLACE

**BEARING AND DISTANCE TO ABOVE IDENTIFIED SURVEY ACCESSORIES:**

BEARING-	FEET-	
S 70 1/2° W	57.5	38" FIR (ORIGINAL "C")
62° W	16.0	8" FIR WITH WTCO PLATE AND "W" NAIL
S 81° W	62.0	2" INCENSE CEDAR PLATE & "W" NAIL

CS 53/1-44  
A

1218

ACCESSORIES ADDED THIS DATE

	BEARING	FEET	ORIG. BT	W-NAIL	PLATE	BRASS DISC

IDENTIFIED ON PHOTO:

INFORMATION ON LOCATION OF CORNER AS NOW SET:

DESCRIPTION OF GROUND COVER AND GROUND SLOPE AT CORNER: SALAL PRATRIE

SLOPE 2% EAST

FROM CORNER NORTH: LEVEL

SOUTH: LEVEL - LOGGED TO EAST AND WEST

EAST: 4% LOGGED TO NORTH 1950-58 LOGGED TO SOUTH 1950-1954.

WEST: 4% LOGGED TO SOUTH, GREEN PAPER TO NORTH.

WORK DONE FOR W. T. CO.

BY: \_\_\_\_\_  
ENGINEER - SURVEYOR

DATE: JANUARY 15, 1958

ASSISTED BY: \_\_\_\_\_

UNDER SUPERVISION OF:

\_\_\_\_\_  
 \_\_\_\_\_  
COPIES SENT TO: \_\_\_\_\_

SEAL PAGE 3

CS 53/1-44