

LANE COUNTY RESTORED CORNER

Index 2237

Corner $\frac{1}{4}$ Corner to Sections 23 & 26

Twp. 22 S R. 4 W

From original G. L. O. field notes, dated _____

EVIDENCE FOUND: _____, 19____

Corner _____

Witness _____

Marks _____

From reestablishment field notes, dated _____

EVIDENCE FOUND: _____, 19____

Corner _____


Witness _____

Marks _____

RETRACEMENT NOTES: Set $\frac{3}{4}$ Iron Pipe

Scribed BT's as follows: $\frac{1}{4}$ S BT on 8" Fir N.73°E. 25.2 ft.

P S BT on 8" Fir S.86°15'W. 17.0 ft.

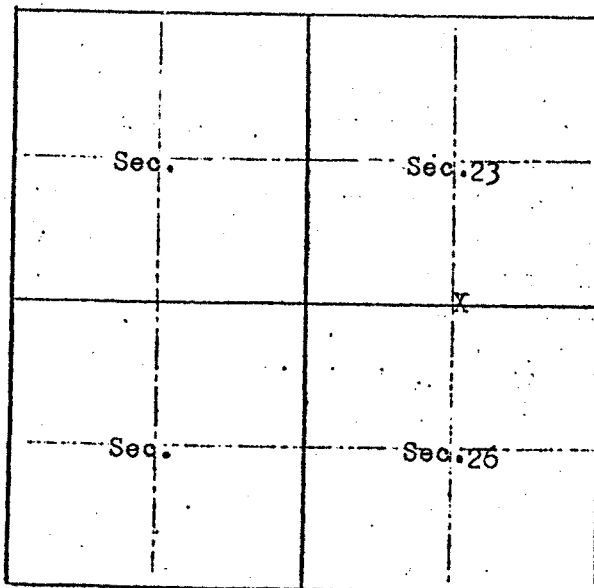

H. R. Jones

Signature

C.S. # 42/385

(for Woodard Lumber Co.)

Title

July, 1958

Date

Douglas County Surveyor's Office

CS 53/1-45