

LANE COUNTY RESTORED CORNER

Index 2289

Corner Southwest corner of Section 36

Twp. 22 S R. 4 W

From original G. L. O. field notes, dated 1854

EVIDENCE FOUND: February 29, 19 60

Corner Post

No trace

10" Fir North 55° West 33 links

no trace

Witness 11" Redwood North 38° East 11 links

no trace

Marks 10" Redwood South 10° East 8 links

no trace

12" Maple South 40° West 47 links

no trace

From reestablishment field notes, dated 1898 C. S.

EVIDENCE FOUND: February 29, 19 60

Corner 16" Fir North 11° West 73 links


No trace

Witness 36" Cedar South 54° West 151 links

no trace

Marks 20" Fir North 52° East 113 links

no trace

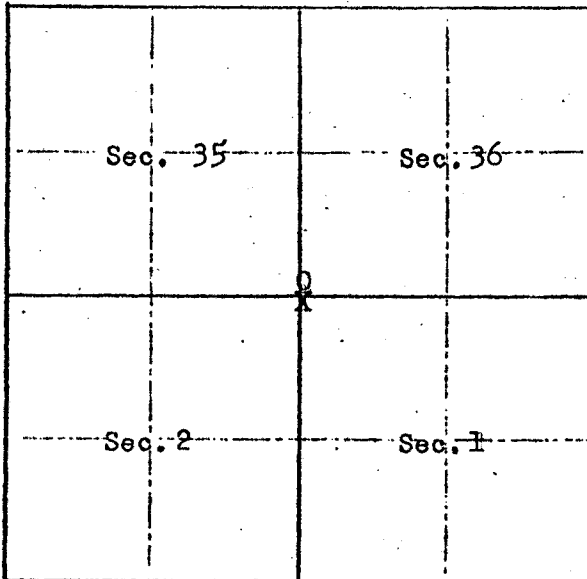

RETRACEMENT NOTES: 3" Alum. square nailed into 12" fir log. Cor. set by
GLO distance between line trees. Plates, "W" nails, 20° declination
12" Red Cedar North 32° East 22.0 feet Brass disc. No. 2149
50" Fir South 79° East 39.9 feet Brass disc. No. 2149
32" Red Cedar stump South 02° West 31.4 feet brass disc. No. 2149
66" Fir North 45° West 28.6 feet Brass disc No. 2149

Glen McChesney

Signature

March 25, 1960

Date

Land Agent

Title

CS 53/1-47