

LANE COUNTY RESTORED CORNER

Index 2301

Corner West quarter corner Section 36

Twp. 22 S R. 4 W

From original G. L. O. field notes, dated 1884

EVIDENCE FOUND: February 17, 19 60

Corner Post and stone

Found mound of stone

5" Spruce South 40° East 45 links

Gone

Witness _____

Marks 14" Cedar North 60° West 21 links

36" Incense Cedar - scribing visible


From reestablishment field notes, dated _____

EVIDENCE FOUND: _____, 19 _____

Corner _____

Witness _____

Marks _____

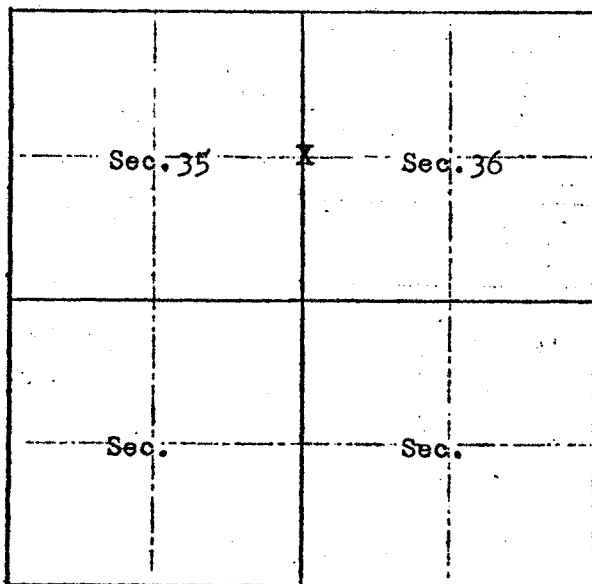

RETRACEMENT NOTES: 2" x 2" x 30" yew post in mound of stone. Plates and "W" nails. Declination 20"

14" Fir North 89° East 10.2 feet

36" Inc. Cedar North 60° West 13.1 feet Orig. B.T.

Glen McChesney

Signature

March 18, 1960

Date

Land Agent

Title

CS 53/i-48