

LANE COUNTY RESTORED CORNER

Index 2315



Corner South quarter corner Section 24

Twp. 22 S R. 4 W

From original G. L. O. field notes, dated 1884

Corner Post and stone

6" Laurel North 11° West 50 links

Witness 36" Fir South 3° East 130 links

Marks _____

From reestablishment field notes, dated _____

Corner _____

Witness _____

Marks _____


EVIDENCE FOUND: October 27, 19 59

No trace, destroyed by logging

Gone

48" Fir scribing visible in upper face

EVIDENCE FOUND: _____, 19 _____

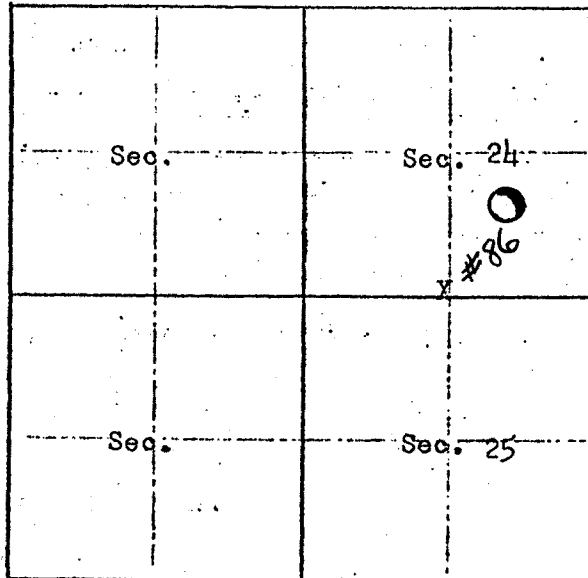

RETRACEMENT NOTES: Set 1" Alum. pipe, "W" nails and plates 20° declination

46" Fir South 2° East 84.9 feet

12" Fir North 33° West 26.2 feet

Glen McChesney

Signature

November 20, 1959

Date

Land Agent

Title

CS 53/1-50