

LANE COUNTY RESTORED CORNER

Index 2387

Corner South quarter corner Section 36

Twp. 22 S R. 4 W

From original G. L. O. field notes, dated 1851

EVIDENCE FOUND: March 17, 1960

Corner Post

GONE

17" Fir North 22° East 26 links

38" Fir windfall - faces up filled with dirt. Upper face rotted.

Witness _____

Marks 28" Fir South 57½° West 70 links

Remains of roots of large Fir.


From reestablishment field notes, dated _____

EVIDENCE FOUND: _____, 19____

Corner _____

Witness _____

Marks _____

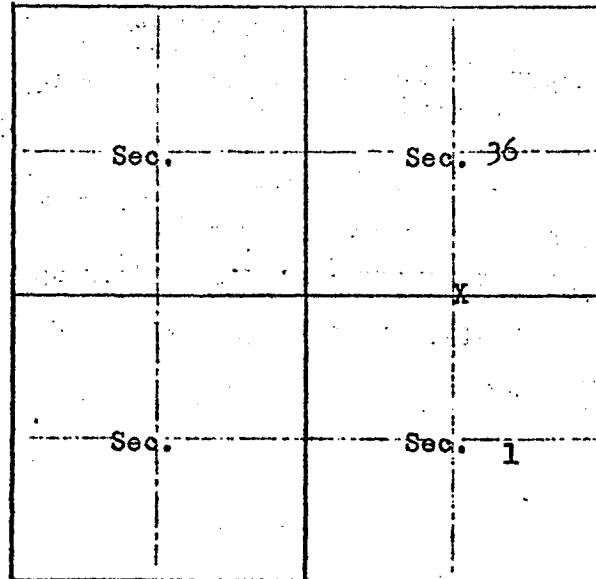

RETRACEMENT NOTES: Found 1" Iron pipe 6" out of ground.

Drove 1" Alum. pipe beside Iron Pipe

Plates, "W" nails 20° Declination

26" Fir North 71° West 11.9 feet

50" Fir South 75° West 15.6 feet

GLEN McCHESNEY *MEVECHAFUSER T. CO.*

Signature

May 27, 1960
Date

Land Agent
Title

CS 53/1-54